

CENTRAL MAPPING AUTHORITY

GEODETIC SURVEY OF N.S.W.

GEODETIC STATION RECONNAISSANCE and MAINTENANCE REPORT

STATION: *ULONG* No.: *TS 4505*

MAP SHEET SCALE 1:250 000 *NARRANDERA*

INSPECTED BY: *P. Naylor* DATE: *13.7.77*

AUTHORITY: *C. M. A.* FIELD BOOK:

Description:
 1. Cleared by lanes bearing.....
 Note: *Cross out word or words which do not apply*

2. Mast & Vanes have been painted white & black respectively,..... from Trig. Mast

3. The station/~~pillar~~ was unplied/~~not unplied~~/constructed on.....*13.7.19.77* dimensions now being:

Description of mark:
Remains of Trig. Pillar found
 S/Steel Pillar Plate, Steel plug, Brass plug, Bolt, G.I. Pipe
No Beacon remains of con only found.
 Height of mark.....m. above rock/concrete; Mark is.....m. above G.L.

Height of Top Vanes to Top Mark/Pillar plate.....m. Diameter of Vanes (vertical).....m.

Height of Cairn.....m. Diameter of Cairn.....m. Name Plate found/not found/placed.

Length of Mast.....m. (approximate if not unplied)

4. A.....set in conc/rock has been placed/found, bearing.....°M from Mast/Plug/Pillar

5. A.....set in conc/rock has been placed/found, bearing.....°M from Mast/Plug/Pillar

6. A.....set in conc/rock has been placed/found, bearing.....°M from Mast/Plug/Pillar

7. A.....set in conc/rock has been placed/found, bearing.....°M from Mast/Plug/Pillar

8. Action required:.....
Station is suitable for concrete pillar.

STANDPOINT:

STANDPOINT:

Mark	Direction	Horiz. Distance	Height Difference	Mark	Direction	Horiz. Distance	Height Difference
			above standpt.				above standpt.
			below standpt.				below standpt.
			above standpt.				above standpt.
			below standpt.				below standpt.

Prepared by: *P. Naylor*

Checked: *B. B. B.*

Noted on U.T.M. Chart

Checked

S: 2735-1

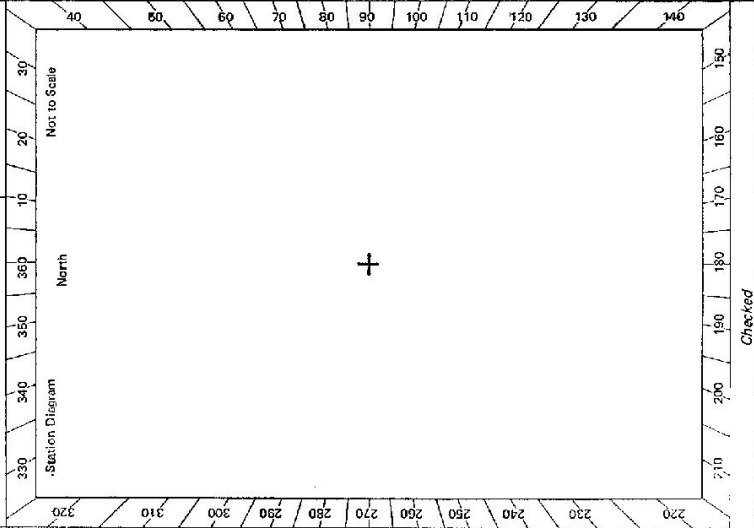

St 2738 - 2 D. West, Government Printer

<p>Beacon Diagram</p>	<p>Net to Scale</p>	<p>STATION</p> <p style="text-align: center; font-size: 1.2em;">ULONG. TS 4505</p>	<p>Owner's Name: W.P.C</p> <p>Address: C. GRIFFITH</p> <p>Phone:</p> <p>Current Occupant: F.A.G.P. Coward</p> <p>Address: Mafara "is Critik</p> <p>Manager: Barry Swan</p> <p>Phone:</p> <p style="text-align: center;">ACCESS</p> <p>Access Report of 13.7.19.77 was found suitable/unavailable.</p> <p>Mazandera 1:250,000 MAP REF. 415/752</p> <div style="text-align: center;"> <p style="text-align: right; font-weight: bold;">ALTERNATE ACCESS IS ALSO AVAILABLE FROM MR. SWAN.</p> </div>
<p>This section to be completed by officer constructing pillar.</p> <p>Original station mark found/not found.</p> <p>Description of mark:</p> <p>Original beacon found/not found.</p> <p>Description of beacon:</p> <p>Height Top of Vanes to Top Mark:m.</p> <p>Height of mark:m. above G.L. below rock/conc.</p> <p>Diameter of Vanesm. Height of Cairnm.</p> <p>Original Beacon has/has not been destroyed by me.</p>		<p>Date</p> <p>Record of Station</p>	