



STATION ULTIMO T.S. 4507


Owners Name.....  
Current Occupant.....

Address.....  
Address.....


Access CONVENTIONAL VEHICLE 1-3-1977

Access to roof of Govt Printing Office; must have approval of security officers  
This is obtainable from Main Entrance Harris St; security guard will give directions for acquisition of key to door of Northern Tower.

N.B. It is advisable to take at least 30ft of rope as ladder from bottom section of tower to top. is very narrow and awkward getting heavy gear to rooftop.

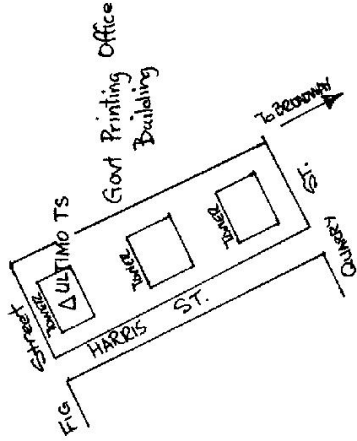

D. West, Government Printer, New South Wales - 1976

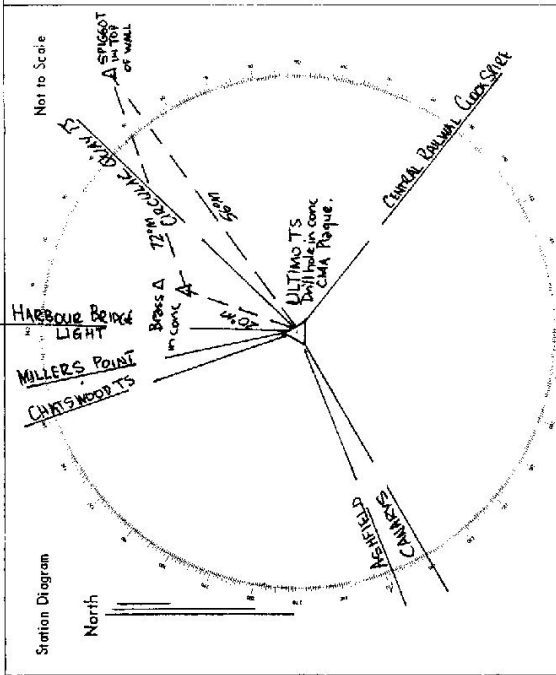

List of Observed Directions:-

Standpoint: DRILL HOLE		Standpoint: BRASS A	
Station	Direction	Station	Direction
CHATSWOOD TS	359° 59'	CIRCULAR QUAY TS	355° 59' 60"
CIRCULAR QUAY TS	55° 36' 59"	SPAGGOT ON WALL	28° 36' 22"
CENTRAL RAILWAY TS	146° 27' 12"	ULTIMO TS	160° 01' 58"
MESHFIELD TS	297° 35' 58"		
Drill Hole		Drill Hole	
Station	Direction	Station	Direction
CIRCULAR QUAY	359° 59' 60"	CHATSWOOD TS	355° 59' 60"
Central Railway	90° 50' 18"	BRASS A	35° 36' 58"
Chartfield	146° 26' 37"	CIRCULAR QUAY TS	55° 37' 04"
MESHFIELD	297° 38' 50"	SPAGGOT ON WALL	67° 53' 45"
MILLERS POINT	327° 11' 09"	CENTRAL RAILWAY TS	146° 27' 26"
HARRIS BRIDGE LIGHT	341° 35' 04"		