

CENTRAL MAPPING AUTHORITY

GEODETIC SURVEY OF NSUK

GEODETIC STATION RECONNAISSANCE and MAINTENANCE REPORT

Description:

1. Cleared by lanes bearing.....  
 Note: Cross out word or words which do not apply  
 from Trig, Mast

2. Mast & Vanes have been painted white & black respectively.

3. The station/pillar was unpiled/not unpiled/constructed on.....19....., dimensions now being:

Description of mark.....should be explicit, e.g., S/Steel Pillar Plate, Steel plug, Brass plug, Bolt, G.I. Pipe

Height of mark.....m. <sup>above</sup> <sub>below</sub> rock/concrete; Mark is.....m. <sup>above</sup> <sub>below</sub> G.L.

Height of Top Vanes to Top Mark/Pillar plate.....m. Diameter of Vanes (vertical).....m.

Height of Cairn.....m. Diameter of Cairn.....m. Name Plate found/not found/placed.

Length of Mast.....m. (approximate if not unpiled)

4. A.....set in conc/rock has been placed/found, bearing.....°M from Mast/Plug/Pillar

5. A.....set in conc/rock has been placed/found, bearing.....°M from Mast/Plug/Pillar

6. A.....set in conc/rock has been placed/found, bearing.....°M from Mast/Plug/Pillar

7. A.....set in conc/rock has been placed/found, bearing.....°M from Mast/Plug/Pillar

8. Action required:.....

STANDPOINT:

Mark	Direction	Horiz. Distance	Height Difference	Mark	Direction	Horiz. Distance	Height Difference
			above standpt.				above standpt.
			below standpt.				below standpt.
			above standpt.				above standpt.
			below standpt.				below standpt.
			above standpt.				above standpt.
			below standpt.				below standpt.
			above standpt.				above standpt.
			below standpt.				below standpt.

Prepared by: *K. Habon* April 1978 Checked: *K. Habon*

Noted on U.T.M. Card


Sr.2733-1

STATION: **UNGARIE** No.: **TS 4514**

MAP SHEET SCALE 1:250,000 **FORBES**

INSPECTED BY: **K. Habon** DATE: **March 1978**

AUTHORITY: **C.M.A.** FIELD BOOK:

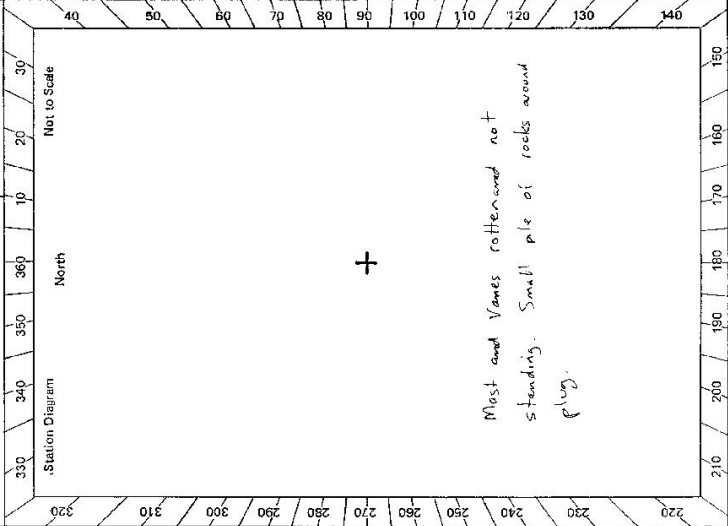

Checked

G

St 2733-2 D. West, Government Printer Beacon Diagram	<table border="1" style="width: 100%; border-collapse: collapse;"> <tr> <td style="width: 10%; text-align: center;">STATION</td> <td style="width: 10%; text-align: center;">UNGAIRIE</td> <td style="width: 10%; text-align: center;">IS</td> <td style="width: 10%; text-align: center;">4514</td> </tr> <tr> <td>Owner's Name: .....</td> <td>Current Occupant: .....</td> <td colspan="2"></td> </tr> <tr> <td>Address: .....</td> <td>Address: .....</td> <td colspan="2"></td> </tr> <tr> <td>Phone: .....</td> <td>Phone: .....</td> <td colspan="2"></td> </tr> <tr> <td colspan="4" style="text-align: center;">                     Access Report of <b>March</b> / <b>1978</b> was found suitable/unsuitable. <span style="float: right;">ACCESS</span> </td> </tr> <tr> <td colspan="4">                     From Ungarie proceed south east towards West Wyalong for 4km.                      Turn left and follow gravel road 0.8km.                      Turn left and proceed through gate and keep right.                      From gate trig is 0.5km.                 </td> </tr> </table>	STATION	UNGAIRIE	IS	4514	Owner's Name: .....	Current Occupant: .....			Address: .....	Address: .....			Phone: .....	Phone: .....			Access Report of <b>March</b> / <b>1978</b> was found suitable/unsuitable. <span style="float: right;">ACCESS</span>				From Ungarie proceed south east towards West Wyalong for 4km. Turn left and follow gravel road 0.8km. Turn left and proceed through gate and keep right. From gate trig is 0.5km.				Not to Scale
STATION	UNGAIRIE	IS	4514																							
Owner's Name: .....	Current Occupant: .....																									
Address: .....	Address: .....																									
Phone: .....	Phone: .....																									
Access Report of <b>March</b> / <b>1978</b> was found suitable/unsuitable. <span style="float: right;">ACCESS</span>																										
From Ungarie proceed south east towards West Wyalong for 4km. Turn left and follow gravel road 0.8km. Turn left and proceed through gate and keep right. From gate trig is 0.5km.																										
This section to be completed by officer constructing pillar.																										
Original station mark found/not found.																										
Description of mark: .....																										
Original beacon found/not found.																										
Description of beacon: .....																										
Height Top of Vanes to Top Mark .....m.																										
Height of mark .....m. above rock/cons .....m. below G.L.																										
Diameter of Vanes .....m. Height of Cairn .....m.																										
Original Beacon has/has not been destroyed by me.																										

Date	Record of Station