

CENTRAL MAPPING AUTHORITY

GEODETIC SURVEY OF N.S.W.

GEODETIC STATION RECONNAISSANCE and MAINTENANCE REPORT

Description:

1. Cleared by lances bearing 0° to 170° from Trig. Mast
Note: Cross out word or words which do not apply
2. Mast & Vanes have been painted white & black respectively.
3. The station/~~plate~~ ~~was~~ ~~replaced~~/not unpiled/~~replaced~~ on 2.2 to $1.19.15$ dimensions now being:
Description of mark.....should be explicit, e.g., S/Steel Pillar Plate, Steel plug, Brass plug, Bolt, G.I. Pipe
Height of mark.....m. ^{above} rock/concrete; Mark is.....m. ^{above} G.L.
- Height of Top Vanes to Top Mark/Pillar platem. Diameter of Vanes (vertical).....m.
- Height of Cairn.....m. Diameter of Cairn.....m. Name Plate found/not found/placed.
- Length of Mast.....m. (approximate if not unpiled)
4. A.....set in conc/rock has been placed/found, bearing..... $^{\circ}$ M from Mast/Plug/Pillar
5. A.....set in conc/rock has been placed/found, bearing..... $^{\circ}$ M from Mast/Plug/Pillar
6. A.....set in conc/rock has been placed/found, bearing..... $^{\circ}$ M from Mast/Plug/Pillar
7. A.....set in conc/rock has been placed/found, bearing..... $^{\circ}$ M from Mast/Plug/Pillar
8. Action required:

STANDPOINT:

STANDPOINT:

Mark	Direction	Horiz. Distance	Height Difference	Mark	Direction	Horiz. Distance	Height Difference
			above standpt.				above standpt.
			below				below
			above standpt.				above standpt.
			below				below
Prepared by: *W.M. Miller*

Checked: *18.09*

Notes on U.T.M. Grid

SI 2733-1

STATION: **URIALLA** TS No.: **4528**

MAP SHEET SCALE 1:250 000 **CANBERRA**

INSPECTED BY: **W. MILLER** DATE: **22-11-78**

AUTHORITY: **CMA** FIELD BOOK:

Station Diagram

Checked


STATION URIALLA TS 4528

Owner's Name:
 Address:
 Phone:

Current Occupant:
 Address:
 Phone:

ACCESS

Access Report of 22.11.78 was found suitable/unsuitable.

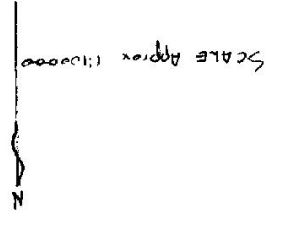


SCALE Approx 1:100000



Date	22.11.78
Record of Station	Visited <i>AMM</i>

St 2733-2 D. West, Government Printer

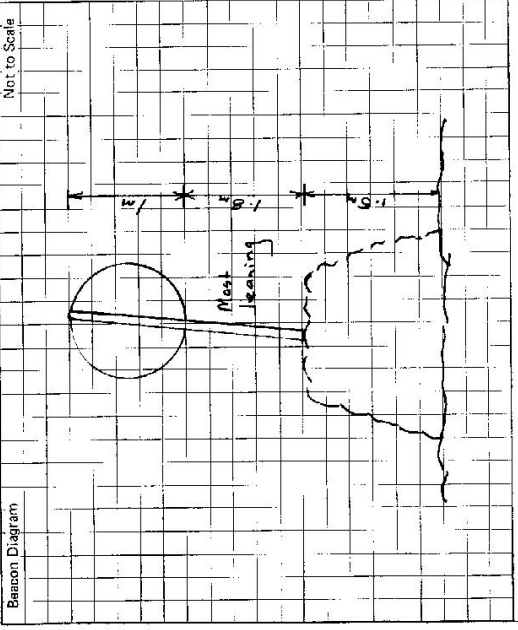

This section to be completed by officer constructing pillar.

Original station mark found/not found.

Description of mark:

Original beacon found/not found.

Description of beacon:

Height Top of Vanes to Top Markm.

Height of markm above G.L. / below G.L.

Diameter of Vanesm. Height of Cairnm.

Original Beacon has/has not been destroyed by me.