

CENTRAL MAPPING AUTHORITY

GEODETIC SURVEY OF M.S.W.

GEODETIC STATION RECONNAISSANCE and MAINTENANCE REPORT

- Description: *Note: Cross out word or words which do not apply*
- Cleared by lanes bearing..... Timbered 360 thick, light timber..... from Trig. Mast easily (amed or 360)
  - Mast & Vanes have been painted white & black respectively.
  - The station/pillar was ~~unpiled~~ reconstructed on..... 19..... dimensions now being: Description of mark..... should be explicit, e.g., S/Steel Pillar Plate, Steel plug, Brass plug, Bolt, G.I. Pipe Height of mark..... m. above rock/concrete; Mark is..... m. above G.L.
  - Height of Top Vanes to Top Mast/Pillar plate..... 2.30 m. Diameter of Vanes (vertical)..... 0.31 m.
  - Height of Cairn..... 1.7 m. Diameter of Cairn..... 2.4 m. Name Plate found/not found/placed.
  - Length of Mast..... 4.1 m. (approximate if not unpiled)
  - A..... set in conc./rock has been placed/found, bearing..... M from Mast/Plug/Pillar
  - A..... set in conc./rock has been placed/found, bearing..... M from Mast/Plug/Pillar
  - A..... set in conc./rock has been placed/found, bearing..... M from Mast/Plug/Pillar
  - A..... set in conc./rock has been placed/found, bearing..... M from Mast/Plug/Pillar

Action required:..... BUNSONIA.....  
 1:25,000

STANDPOINT:							
Mark	Direction	Horiz. Distance	Height Difference	Mark	Direction	Horiz. Distance	Height Difference
			above standpt.				above standpt.
			below				below
			above standpt.				above standpt.
			below				below
Bush Fire Group contacted  
 CMA 25/7/16 notifying CMA  
 of Nearby Fire Trail (25/7/16)  
 (See 12.5 km on Access)

Prepared by:.....  
 Checked:.....

St 2738-1

STATION: **VESSEY** No.: **4542**

MAP SHEET SCALE 1:250 000 **Goulburn**

INSPECTED BY: **A. Sivertsen** DATE: **8-11-78**

AUTHORITY: **CMA** FIELD BOOK: **1717**

Station Diagram North

Old vanes on ground 1-09

Present beacon erected 1942 according to owner in good condition

Extensive views when cleared

Note: Owner will grant permission for fence to be opened to clear Δ of place pillar.

Phone owner at least a couple of days before visiting Δ for the first time to arrange for front gate to be unlocked.

Checked

Sr 2730-2 D. West, Government Printer

STATION **VESSEY TS 4542**

Owner's Name: <b>MR. R. M. TICKNER</b> Address: <b>"Glenless"</b> <b>RMB 215 MARULAN</b> Phone: <b>S71672</b>	Current Occupant: Address: Phone:	ACCESS <b>LOCKED GATE - Phone number 2 days before going to A. (9:00pm good time)</b> From <b>MARULAN take Hwy south for 3km of take MARULAN SOUTH</b> to <b>BUNCONIA road. at 0.0 km.</b> 0.0 Take <b>BUNCONIA road to L then R</b> 6.0 <b>Bridge</b> 6.9 <b>BS, M6 milepost</b> 8.1 <b>Turn head R through gate. "Glenless" GATE IS LOCKED.</b> 10.3 <b>Gate</b> 11.0 <b>Gate then past woolshed</b> 11.1 <b>Through gate below fallen shed. Call at house.</b> 11.7 <b>Take left fork (main track)</b> 11.9 <b>Gate</b> 12.5 <b>Gate then turn L up fire trail</b> 16.1 <b>At crest take wheeltracks to R</b> 16.6 <b>Fence. 10-15 m walk along wheeltracks</b> to <b>A VESSEY</b>
--	---	---

Not to Scale	
	Beacon Diagram
	This section to be completed by officer constructing pillar. Original station mark found/not found. Description of mark: ..... Original beacon found/not found. Description of beacon: ..... Height Top of Vanes to Top Mark: .....m. Height of mark: .....m. above G.L. below G.L. Diameter of Vanes: .....m. Height of Cairn: .....m. Original Beacon has/has not been destroyed by me.

	Record of Station
Date	

CENTRAL MAPPING AUTHORITY

GEODETTIC STATION RECONNAISSANCE and MAINTENANCE REPORT

STATION: **VESSEY** No.: **4542**

MAP SHEET  
SCALE 1:250 000


INSPECTED BY: **R. ELLIS**

DATE: **07-07-21**

FIELD BOOK: **0135**

DESCRIPTION: **Station Diagram**

1. ~~Cleared by James bearing~~ **HILL COMPLETELY OVERTAKEN**..... from Trig. Mast  
*Note: Cross out word or words which do not apply*
2. ~~Mast & Vanes have been painted white & black respectively~~
3. The station/pillar was ~~applied~~ **not unpiled/erected** on **02/02/1981**, dimensions now being:  
Description of mark..... should be explicit, e.g., S/Steel Pillar Plate, Steel plug, Brass plug, Bolt, G.I. Pipe  
Height of mark.....m. <sup>above</sup> ~~below~~ rock/concrete; Mark is.....m. <sup>above</sup> ~~below~~ G.L.  
Height of Top Vanes to Top Mark/Pillar plate.....m. Diameter of Vanes (vertical).....m.  
Height of Cairn.....m. Diameter of Cairn.....m. Name Plate found/not found/placed.  
Length of Mast.....m. (approximate if not unpiled)
4. A.....set in conc/rock has been placed/found, bearing.....°M from Mast/Plug/Pillar
5. A.....set in conc/rock has been placed/found, bearing.....°M from Mast/Plug/Pillar
6. A.....set in conc/rock has been placed/found, bearing.....°M from Mast/Plug/Pillar
7. A.....set in conc/rock has been placed/found, bearing.....°M from Mast/Plug/Pillar
8. Action required: **EXCELENT CON. PILLAR. SITE ... MARKING... RECORDED.**

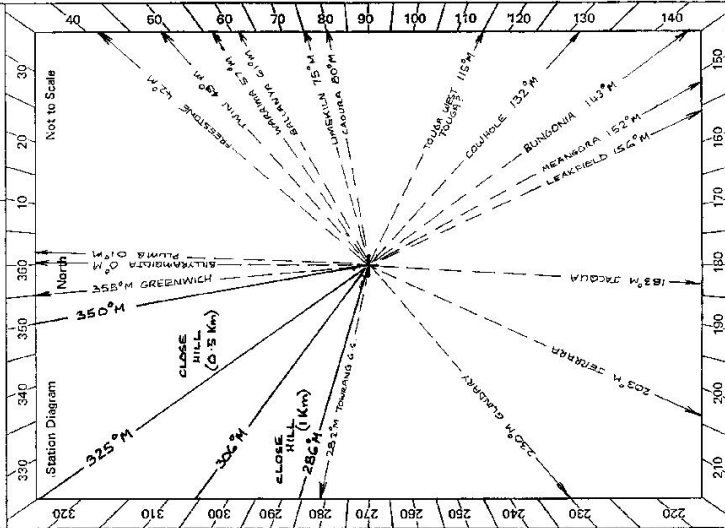

STANDPOINT:

Mark	Direction	Horiz. Distance	Height Difference	Mark	Direction	Horiz. Distance	Height Difference
			above standpt.				above standpt.
			below				below
			above standpt.				above standpt.
			below				below
Prepared by: *[Signature]*

Checked: *[Signature]*

Sr. 2733-1

Noted on U.T.M. Card

GS 24

STATION **YESSEY TS 4542**

Owner's Name: **TR - 18266**  
 Address: .....  
 Phone: .....

Current Occupant: **R.M. TICKNER**  
 Address: **"GLENLOSS"**  
 Phone: **MARUKAN**

Access Report of **09/07/1981** was found suitable/unsuitable.  
 Feature  
 KM  
 D.O  
**INTERSECTION OF PRINKES HUY AND BUNGENIA RD THREE KM SOUTH OF MARUKAN. DRIVE ALONG BUNGENIA RD AND TURN LEFT JUST AFTER INTERSECTION**  
**6.0 BRIDGE**  
**8.1 TURN HARD RIGHT \* LOCKED GATE \* RING OWNER 2 DAYS BEFORE ENTERING TO GET GATE UNLOCKED.**  
**10.3 GATE**  
**11.0 GATE ~ THEN PAST WOOLSHED**  
**11.1 THROUGH GATE NEAR LEAVING SHED - "GLENLOSS" HOMESTEAD ON RIGHT**  
**11.7 TAKE LEFT FORK**  
**11.9 GATE**  
**12.5 GATE, THEN TURN LEFT UP HILL AND FOLLOW FIRETRAIL**  
**16.1 AT CREST OF HILL TURN RIGHT AND FOLLOW FIRETRAIL**  
**16.6 DRIVE OVER FENCE.**  
**17.5 "VESSEY" TRIG.**

Beacon Diagram

Not to Scale

**CHAIR, ABLE & DISCS IN RESPONSIBLE CONVICTION**

**- COULD BE CLEARED 360° IN 2-3 DAYS OR LANED IN 1-2 DAYS**

**- HILL COVERED IN POOR SHE OAKS & GUMS - EARLY SCATTERED**

**- VERY GOOD CONC PILLAR SITE - BROKEN SHALE TYPE**

**GROUND**

This section to be completed by officer constructing pillar.  
 Original station mark found/not found.  
 Description of mark: .....  
 Original beacon found/not found.  
 Description of beacon: .....  
 Height Top of Vanes to Top Mark: ..... m.  
 Height of mark: ..... m. above rock/conc. ..... m. below G.L.  
 Diameter of Vanes: ..... m. Height of Cairn: ..... m.  
 Original Beacon has/has not been destroyed by me.

Date	Record of Station