

CENTRAL MAPPING AUTHORITY

GEODETIC SURVEY OF N.S.W. GEODETIC STATION RECONNAISSANCE and MAINTENANCE REPORT

Description:

1. Cleared by lanes bearing.....
 Note: Cross out word or words which do not apply
 for total clearing about 2 hours work with AXE from Trig. Mast Pillar
 Mast & Vanes have been painted white & black respectively. (Cleared small Redgum Trees)
3. The station/pillar was unspiled/not unspiled/constructed on.....
 Description of mark.....should be explicit, e.g., S/Steel Pillar Plate, Steel plug, Brass plug, Bolt, G.I. Pipe
 Height of mark.....m. ^{above} rock/concrete; Mark is.....m. ^{above} below G.L.
- Height of Top Vanes to Top Mark/Pillar plate.....m. Diameter of Vanes (vertical).....m.
- Height of Cairn.....m. Diameter of Cairn.....m. Name Plate found/not found/placed.
- Length of Mast.....m. (approximate if not unspiled)
4. A.....set in conc./rock has been placed/found, bearing.....°M from Mast/Plug/Pillar
5. A.....set in conc./rock has been placed/found, bearing.....°M from Mast/Plug/Pillar
6. A.....set in conc./rock has been placed/found, bearing.....°M from Mast/Plug/Pillar
7. A.....set in conc./rock has been placed/found, bearing.....°M from Mast/Plug/Pillar
8. Action required:.....

STANDPOINT:

Mark	Direction	Horiz. Distance	Height Difference	Mark	Direction	Horiz. Distance	Height Difference
			above standpt.				above standpt.
			below				below
			above standpt.				above standpt.
			below				below
Prepared by:

Checked:

Noted on U.T.M. Card

ST 2733-1

STATION: VINCENT (Pillar) No.: TS 4546
 MAP SHEET SCALE 1:250 000
 INSPECTED BY: D.J. KAW DATE: 15th AUGUST 19
 AUTHORITY: C.M.A. FIELD BOOK: Q1651

Station Diagram

North

Not to Scale

Checked


Vincent (Pillar) TS 4546

STATION

Current Occupant:
 Address:
 Phone:

Owner's Name: SATURNIA SITUATED
 Address: CA TRIS RESERVE
 Phone:

Access Report of:/19 was found suitable/unsuitable. ACCESS

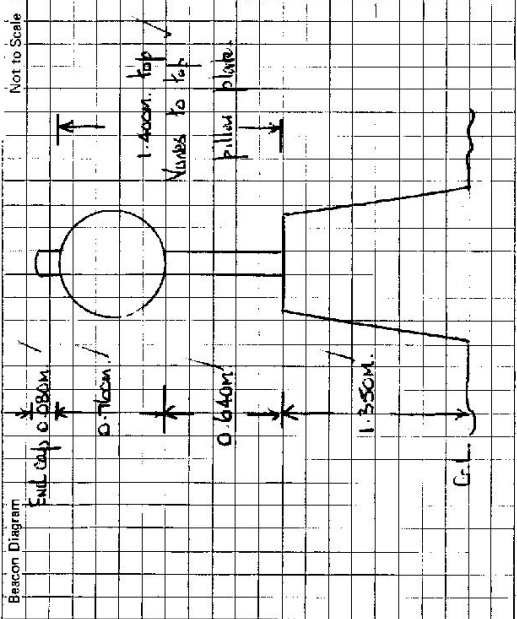

This section to be completed by officer constructing pillar.

Original station mark found/not found.

Description of mark:

Original beacon found/not found.

Description of beacon:

Height Top of Vanes to Top Mark:m.

Height of mark:m. above G.L. / below G.L.

Diameter of Vanes:m. Height of Cairn:m.

Original Beacon has/has not been destroyed by me.

Date	Record of Station

CENTRAL MAPPING AUTHORITY

GEODETIC SURVEY OF N.S.W.

GEODETIC STATION RECONNAISSANCE and MAINTENANCE REPORT

- Description:
- Cleared by lanes bearing..... 84° / 101° M..... 772° / 332° M..... from Trig. Mast
 Note: Cross out word or words which do not apply
 MAINTENANCE
 - Mast & Vanes have been painted white & black respectively. ✓
 - The station/pillar was ~~replaced~~ ~~replaced~~ on..... 22° / 5° 19.85° , dimensions now being:
 Description of mark $5.8 \times 1.1 \times 1.1$ m. should be explicit, e.g., S/Steel Pillar Plate, Steel plug, Brass plug, Bolt, G.I. Pipe
 Height of mark..... 3.70 m. above ~~rock~~ ~~concrete~~ Mark is..... $A.T.$ 15 m. G.L.
 Height of Top Vanes to Top Mark/Pillar plate..... 4.4 m. Diameter of Vanes (vertical)..... 15 m.
 Height of Cairn..... m. Diameter of Cairn..... m. Name Plate found/ ~~not found~~ / placed.
 Length of Mast..... 1.185 m. (approximate if not supplied) " Vincent T.S. 1972 ✓
 - A..... set in conc./rock has been placed/found, bearing..... °M from Mast/Plug/Pillar
 - A..... set in conc./rock has been placed/found, bearing..... °M from Mast/Plug/Pillar
 - A..... set in conc./rock has been placed/found, bearing..... °M from Mast/Plug/Pillar
 - A..... set in conc./rock has been placed/found, bearing..... °M from Mast/Plug/Pillar
 - Action required:.....

STANDPOINT:		STANDPOINT:		STANDPOINT:		STANDPOINT:	
Mark	Direction	Horiz. Distance	Height Difference	Mark	Direction	Horiz. Distance	Height Difference
			above standpt				above standpt
			below				below
			above standpt				above standpt
			below				below
Prepared by: D. H.A.O. Checked: I. H.A.O. 16.7.17 Noted on U.T.M. Card


STATION: Vincent Concrete Pillar No: 4546
 MAP SHEETS SCALE 1:250 000 New South Wales
 INSPECTED BY: D. J. KAIN DATE: 22.5.1985
 AUTHORITY: C.M.A. FIELD BOOK: C431

Station Diagram

Net to Scale

Checked: D. H.A.O. 16.7.17

STATION Vincent Concrete Pillar TS 4546

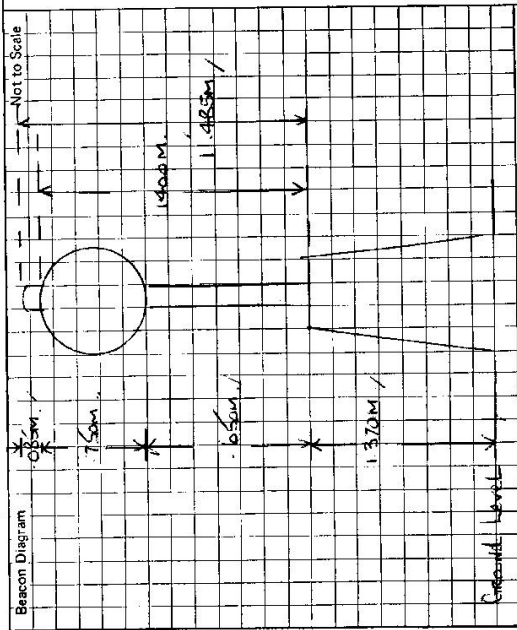

Owner's Name:
 Address:
 Phone:

Current Occupant:
 Address:
 Phone:

ACCESS

Access Report of 28.5.1982 was found suitable/unsuitable.

KMS.

0.00 AT MINNI POST OFFICE TRAVEL SOUTH ALONG
 "/ CAMERON PARK DRIVE."
 "/ 3.92 TURN RIGHT AT "T JUNCTION" ONTO GEORGE BOOTH DRIVE
 "/ TOWARD KURRI KURRI.
 "/ 4.01 PASS WEST WALLSEND TURN - OFF ON L.H.S.
 "/ 5.07 PASS THROUGH VILLAGE OF SENHAMPTON.
 "/ 6.48 TURN LEFT AT SIGNPOST "MOUNT SUGARLOAF."
 "/ 9.70 TURN LEFT ONTO DIRT ROAD "SIGNPOSTS,
 "/ G.M.T. VINCENT, "SUGARLOAF RANGE ROAD."
 "/ 10.53 / 13.31 OVER STEEL GRIDS. "SUMMIT POINT PICNIC AREA"
 "/ 13.61 TRAVEL STRAIGHT AHEAD PASSING "ROAD ON YOUR R.H.S."
 "/ 14.60 PASS "SUGARLOAF RANGE ROAD" ON YOUR L.H.S.
 "/ 15.04 OVER STEEL GRID.
 "/ 15.47 PARK VEHICLE AT PICNIC AREA AND CAR PICK.
 "/ FIVE MINUTE EASY WALK ALONG AND UP FORMER WALKING TRAIL.

DRY WEATHER WOODS TO CONVENTIONAL TYPE VEHICLE.

This section to be completed by officer constructing pillar.

Original station mark found/not found.

Description of mark:

Original beacon found/not found.

Description of beacon:

Height Top of Vanes to Top Markm.
 above G.L.
 below

Height of markm.
 above rock/conc.
 below

Diameter of Vanesm. Height of Cairnm.

Original Beacon has/has not been destroyed by me.

Date	Record of Station