

## CENTRAL MAPPING AUTHORITY

## GEODETTIC SURVEY OF N.S.W.

## GEODETTIC STATION RECONNAISSANCE and MAINTENANCE REPORT

## Description:

1. Cleared by lanes bearing..... *Note: Cross out word or words which do not apply*  
 2. Mast & Vanes have been painted white & black respectively.  
 3. The station/pillar was unpiled/not unpiled/constructed on..... from Trig. Mast

Description of mark..... should be explicit, e.g. S/Steel Pillar Plate, Steel plug, Brass plug, Bolt, G.I. Pipe  
 Height of mark.....m. <sup>above</sup> <sub>below</sub> rock/concrete; Mark is.....m. <sup>above</sup> <sub>below</sub> G.L.  
 Height of Top Vanes to Top Mark/Pillar plate.....m. Diameter of Vanes (vertical).....m.  
 Height of Cairn.....m. Diameter of Cairn.....m. Name Plate found/not found/placed.  
 Length of Mast.....m. (approximate if not unpiled)

4. A..... set in conc/rock has been placed/found, bearing.....°M from Mast/Plug/Pillar  
 5. A..... set in conc/rock has been placed/found, bearing.....°M from Mast/Plug/Pillar  
 6. A..... set in conc/rock has been placed/found, bearing.....°M from Mast/Plug/Pillar  
 7. A..... set in conc/rock has been placed/found, bearing.....°M from Mast/Plug/Pillar  
 8. Action required:.....

## STANDPOINT:

## STANDPOINT:

Mark	Direction	Horiz. Distance	Height Difference	Vark	Direction	Horiz. Distance	Height Difference
			above below standpt				above below standpt
			above below standpt				above below standpt
Prepared by:

Checked:

Noted on U.T.M. Card

St 2732-1

STATION: WARABALONG	No.: 4554
MAP SHEET SCALE 1:250 000	
INSPECTED BY: C. C. HANNA	DATE: 19/5/79
AUTHORITY: C. M. A.	FIELD BOOK:

STATION

WABALONG IS 4554

Owner's Name: .....

Current Occupant: .....

Address: .....

Address: .....

Phone: .....

Phone: .....

ACCESS

See Hillston 8031-S

Access Report of 19.5.1979 was found suitable/unsuitable.

Cairn, mast & vanes seen from East.

Mast & vanes leaning.

Beacon Diagram

Not to Scale

This section to be completed by officer constructing pillar.

Original station mark found/not found.

Description of mark: .....

Original beacon found/not found.

Description of beacon: .....

Height Top of Vanes to Top Mark .....m.

Height of mark .....m. above G.L. below

Diameter of Vanis .....m. Height of Cairn .....m.

Original Beacon has/has not been destroyed by me.

Date

Record of Station

# GEODETTIC STATION RECONNAISSANCE and MAINTENANCE REPORT

**Description:**

- Description:
- Note: Cross out word or words which do not apply
1. Cleared by lanes bearing.....  $294^{\circ}$  -  $306^{\circ}$ m ..... from Trig. Mast  
N<sup>or</sup>
  2. Mast & Vanes have been painted white & black respectively.  
<sup>N<sup>or</sup> S<sup>outh</sup> constructed</sup>
  3. The station pillar was ~~unplaced/not uplited~~/constructed on..... /  $\theta$ .....  $87^{\circ}$ .....  $19\ 27^{\circ}$ ., dimensions now being:  
Description of mark. ~~S/S~~ S/S..... should be explicit, e.g., S/Steel Pillar Plate, Steel plug, Brass plug, Bolt, G.I. Pipe
  - Height of mark.....  $0.0$  m. above rock/concrete; Mark is..... A.T.....m. below G.L.
  - Height of Top Vanes to Top Mark/Pillar plate.....  $3.500$  m. Diameter of Vanes (vertical).....  $76.0$  mm.
  - Height of Cairn.....  $1.40$  m. Diameter of Cairn.....  $1.0$  m. Name Plate found/not found/placed.
  - Length of Mast.....  $3.500$  m. ~ (approximate if not uplited)
4. A..... set in conc./rock has been placed/found, bearing.....  $0^{\circ}$  M from Mast/Plug/Pillar
  5. A..... set in conc./rock has been placed/found, bearing.....  $0^{\circ}$  M from Mast/Plug/Pillar
  6. A..... set in conc./rock has been placed/found, bearing.....  $0^{\circ}$  M from Mast/Plug/Pillar
  7. A..... set in conc./rock has been placed/found, bearing.....  $0^{\circ}$  M from Mast/Plug/Pillar
  8. Action required:.....

## 8. Action requir

**STANDPOINT:**


**STANDPOINT:**

Mark	Direction	Horiz. Distance	Height Difference	Mark	Direction	Horiz. Distance	Height Difference
			above				standpt.
			below				above
			above				below
			below				standpt.
			above				above
			below				below
			above				standpt.
			below				above
			above				below
			below				standpt.
			above				above
			below				below
			above				standpt.
			below				above
			above				below
			below				standpt.
			above				above
			below				below
			above				standpt.
			below				above
			above				below
			below				standpt.

Prepared by: G. Murray

Noted on U.T.M. Card

2733-1

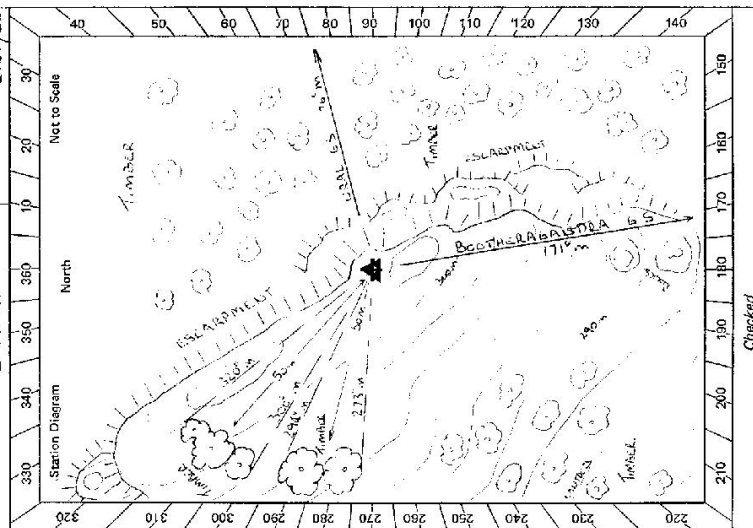

ف

EN 2733-2 C. West: Government Printer

Beacon Diagram	Not to Scale	No.: 4554	STATION	WAB 5920 NC
<div style="display: flex; justify-content: space-between;"> <div> <p>Owner's Name: <u>Mr &amp; Louise LANCORNA</u></p> <p>Address: <u>"LANCORNA"</u></p> <p>Phone: <u>09 67 4 11</u></p> </div> <div> <p>Current Occupant: .....</p> <p>Address: .....</p> <p>Phone: .....</p> </div> </div> <p style="text-align: center;"><u>ACCESS</u></p> <p>Access Report of 11/5/1982 was found suitable/usable as far as the "LANCORNA" property</p> <p>0.0 At front Gate LANCORNA road past</p> <p>2.0 Turn into Barker Road.</p> <p>2.65 Turn right into track</p> <p>2.7 Through gate, follow track</p> <p>3.55 Through double gate</p> <p>4.05 Gate track to the right</p> <p>4.20 Just past dam on left side left fork in track</p> <p>4.85 Occurs shallow gully.</p> <p>5.0 Park car at End of track.</p> <p>Walk from there to the top of the Saddle &amp; then NE to the Trig (30 mins walk)</p>		<p>Date: <u>24/9/99</u></p> <p>Record of Station</p> <p><u>RUE FOUND - NO CARAT NO MAST + VANS</u></p> <p><u>CLEAR ALL AROUND FOR GAS.</u></p>		
		<p>INSPECTED BY: <u>P. BARNOLD</u></p> <p><u>to replace</u></p>		
		<p>Original station mark found/not found: .....</p> <p>Description of mark: .....</p> <p>Original beacon found/not found: .....</p> <p>Description of beacon: .....</p> <p>Height Top of Vane to Top Mark: .....m.</p> <p>Height of mark: .....m. above rock/conc .....m. below above G.L.</p> <p>Diameter of Vane: .....m. Height of Cairn: .....m.</p> <p>Original Beacon has/has not been destroyed by me: .....</p>		
		<p>This section to be completed by officer constructing pillar:</p>		
		<p>Grid lines for diagram</p>		