


STATION TS MADKIRA PILLAR, 4556

Owners Name.....
 Current Occupant.....
 Address.....
 Address.....

- ACCESS 16-8-1977
 Km. Feature
- 0-0 Govokann P.O. Travel towards Elphong along Main Rd.
 - 0-8 Turn left into Dahnoff Rd.
 - 1-7 Right into Marke Rd.
 - 3-05 Left into Tuggerawang Rd.
 - 4-6 Right into Murawal Rd.
 - 5-3 Left into John's Rosa - from Murawal + Kelpa Rds.
 - 6-95 Right into "BARANDAIN STUD"
 - 7-2 Right fork.
 - 7-4 Gate.
 - 7-65 TRUG.

been by 2-wheel drive vehicle.

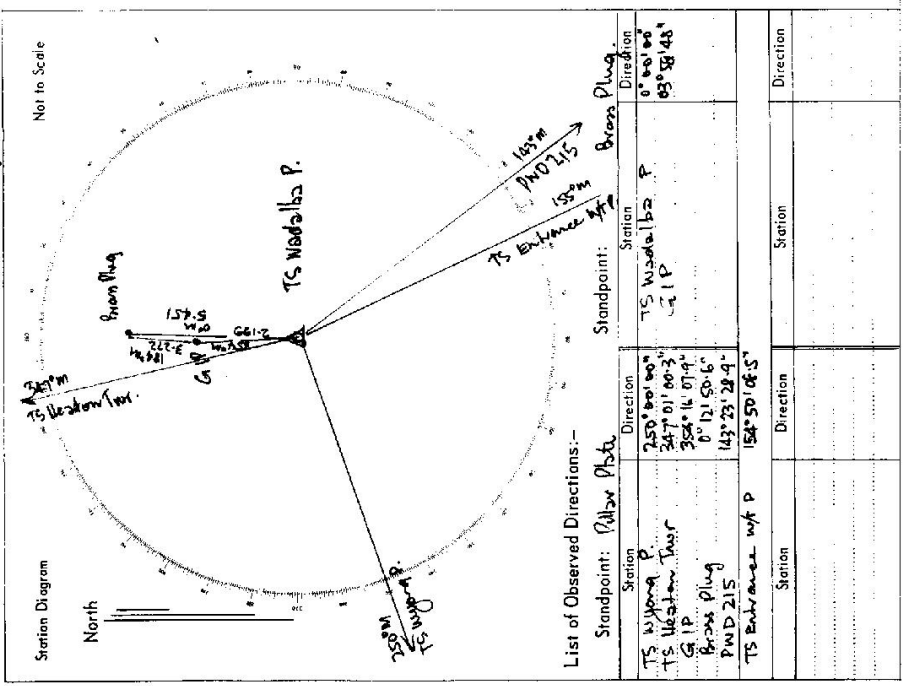

List of Observed Directions:-

Station	Station	Direction	Station	Station	Direction
TS Wagon P.	TS Madkira P.	258° 00' 00"	TS Madkira P.	TS Wagon P.	0° 00' 00"
TS Wagon Pass	TS Madkira P.	347° 01' 00"	TS Madkira P.	TS Wagon Pass	03° 58' 48"
G.P.	TS Madkira P.	358° 16' 07"			
From Plug	TS Madkira P.	0° 12' 50.6"			
PWD 215	TS Madkira P.	143° 23' 28.9"			
TS Entrance W/P	TS Madkira P.	154° 50' 06.5"			
Station	Station	Direction	Station	Station	Direction