

CENTRAL MAPPING AUTHORITY

GEODETIC SURVEY OF A.S.I.W.  
 GEODETIC STATION RECONNAISSANCE and MAINTENANCE REPORT

STATION: **WALBUNDRIE GS** No.: **4563**  
 MAP SHEETS SCALE 1:100 000  
 SCALE 1:250 000 **WALBUNDRIE**  
 INSPECTED BY: **C. L. FORD** DATE: **24/5/88**  
 AUTHORITY: **C. M. A.** FIELD BOOK: **1951**

Description:  
 1. Cleared by lanes bearing **210° - 2.45 M**, **30° - 40°** **LANES AT 240° & 152°** from Trig. Mast  
 2. Mast & Vanes have been painted white & black respectively. ✓  
 3. The station/pillar was unpiled/not unpiled/constructed on.....19....., dimensions now being:  
 Description of mark.....should be explicit, e.g., S/Steel Pillar Plate, Steel plug, Brass plug, Bolt, G.I. Pipe  
 Height of mark.....m. above below rock/concrete; Mark is.....m. above below G.L.  
 Height of Top Vanes to Top Mark/Pillar plate.....m. Diameter of Vanes (vertical).....m.  
 Height of Cairn.....m. Diameter of Cairn.....m. Name Plate found/not found/placed.  
 Length of Mast.....m. (approximate if not unpiled)


4. A.....**SSM**.....set in conc/rock has been placed/found, bearing.....**241**.....°M from Mast/Rug/Pillar
5. A.....set in conc/rock has been placed/found, bearing.....°M from Mast/Plug/Pillar
6. A.....set in conc/rock has been placed/found, bearing.....°M from Mast/Plug/Pillar
7. A.....set in conc/rock has been placed/found, bearing.....°M from Mast/Plug/Pillar

8. Action required: **JACK HAMMER REQUIRED...IF PILLARS MARKS TO BE PLACED... (LANES & ROCK) CLEARING ABOUT 1.0M**

STANDPOINT:

Mark	Direction	Horiz. Distance	Height Difference	Mark	Direction	Horiz. Distance	Height Difference
			above standpt				above standpt
			below standpt				below standpt
			above standpt				above standpt
			below standpt				below standpt
			above standpt				above standpt
			below standpt				below standpt
			above standpt				above standpt
			below standpt				below standpt

Prepared by: **J.L. Ford 22/12/88** Checked: **1988 27.5.88** Noted on U.T.M. Chart

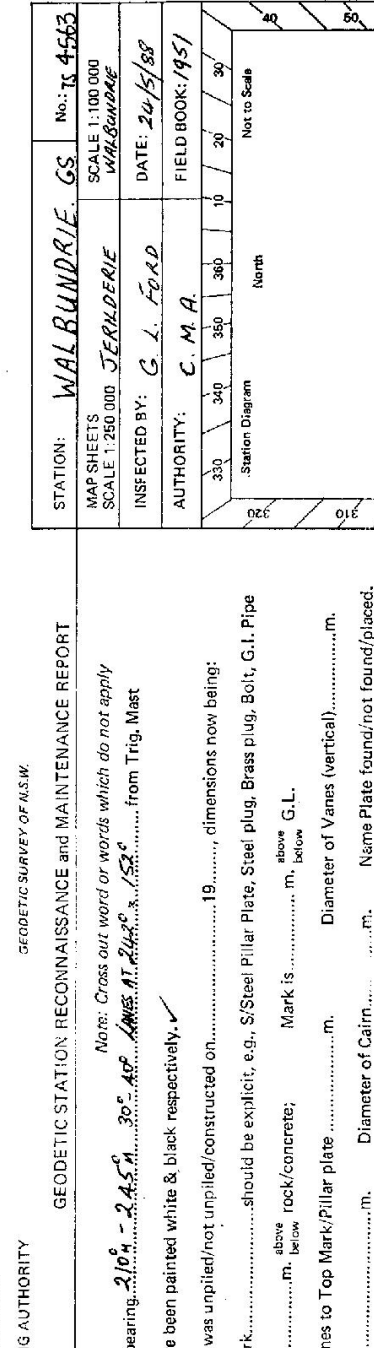


STATION: **WALBUNDRIE GS** No.: **4563**  
 MAP SHEETS SCALE 1:100 000  
 SCALE 1:250 000 **WALBUNDRIE**  
 INSPECTED BY: **C. L. FORD** DATE: **24/5/88**  
 AUTHORITY: **C. M. A.** FIELD BOOK: **1951**

DL 2733-2 D. West Government Printer

STATION WALBUNDRIE GS 15 4563

Beacon Diagram Not to Scale

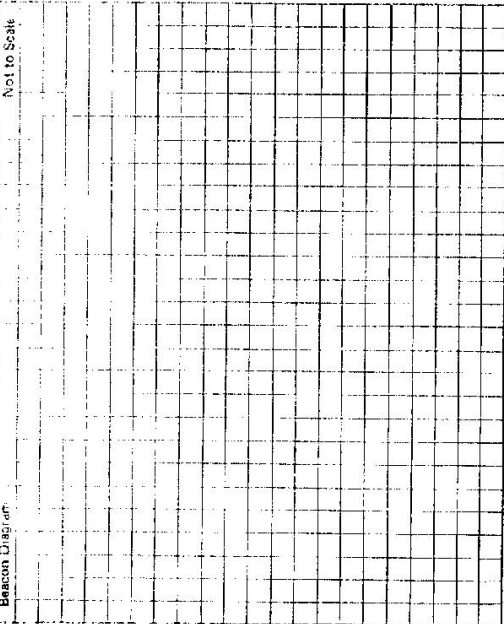

ACCESS  
 Owner's Name M. F. CLEAR  
 Address HILLVIEW  
WALBUNDRIE  
 Phone

Current Occupant:  
 Address  
 Phone

**ACCESS:**

Access Report of S. J. S. 1988 was found suitable/~~unsuitable~~.

STATION IS ON A TRIG RES. 9579

This section to be completed by officer constructing pillar.

Original station mark found/not found.

Description of mark: .....

Original beacon found/not found.

Description of beacon: .....

Height Top of Vane to Top Mark.....m.

Height of mark.....m. above rock/cont.....m. below G.L.

Diameter of Vane.....m.

Height of Cairn.....m.

Original Beacon has/has not been destroyed by me.

Date	Record of Station

GEODETTIC SURVEY OF N.S.W.

CENTRAL MAPPING AUTHORITY

GEODETTIC STATION RECONNAISSANCE and MAINTENANCE REPORT

- Description:
- Note: *Cross out word or words which do not apply*
- Cleared by lanes bearing..... from Trig, Mast
  - Mast & Vanes have been painted white & black respectively.
  - The station/pillar was unpiled/not unpiled/constructed on..... 19....., dimensions now being:  
Description of mark..... should be explicit, e.g., S/Steel Pillar Plate, Steel plug, Brass plug, Bolt, G.I. Pipe  
Height of mark..... m, above rock/concrete; Mark is..... m, above G.L.  
Height of Top Vanes to Top Mark/Pillar plate..... m. Diameter of Vanes (vertical)..... m.  
Height of Cairn..... m. Diameter of Cairn..... m. Name Plate found/not found/placed.  
Length of Mast..... m. Approximate if not unpiled)
  - A..... set in ~~rock~~ *MOUSE* rock has been placed/found, bearing..... °M from Mast/Plug/Pillar
  - A..... set in conc/rock has been placed/found, bearing..... °M from Mast/Plug/Pillar
  - A..... set in conc/rock has been placed/found, bearing..... °M from Mast/Plug/Pillar
  - A..... set in conc/rock has been placed/found, bearing..... °M from Mast/Plug/Pillar
  - Action required: *Paint Mast & Vanes Clear by lanes 2/6/07 to V.C.P. Note - a back lane would be helpful.*

STANDPOINT:

Mark	Direction	Horiz. Distance	Height Difference	Mark	Direction	Horiz. Distance	Height Difference
			above standpt				above standpt
			below standpt				below standpt
			above standpt				above standpt
			below standpt				below standpt
Prepared by: *O. Moss 13/5/08* Checked: *Named on U.T.M. Grid*

