

Batch Id: 1517

LAND INFORMATION CENTRE

GEODETIC SURVEY OF N.S.W.

GEODETIC STATION RECONNAISSANCE and MAINTENANCE REPORT

Note: Cross out word or words which do not apply

- Cleared by vanes bearing..... from Trig. Mast
- Mast & Vanes have been painted white & black respectively.
- The station/~~either~~ ^{was not} ~~was not uplited/constructed~~ on 19.9.1990, dimensions now being: 19.9m
- Description of mark: Bronze pin should be explicit, e.g., S/Steel Pillar Plate, Steel plug, Brass plug, Bolt, G.I. Pipe
Height of mark: 0.015 ^{above} ~~below~~ rock/concrete; Mark is 0.7 ^{above} ~~below~~ G.L.
Height of Top Vanes to Top Mark/Pillar platem. Diameter of Vanes (vertical) Nil.....m.
Height of Cairn.....m. Diameter of Cairn.....m. Name Plate found/not found/placed.
Length of Mastm. (approximate if not uplited)
- A.....set in conc/rock has been placed/found, bearing.....°M from Mast/Plug/Pillar
- A.....set in conc/rock has been placed/found, bearing.....°M from Mast/Plug/Pillar
- A.....set in conc/rock has been placed/found, bearing.....°M from Mast/Plug/Pillar
- A.....set in conc/rock has been placed/found, bearing.....°M from Mast/Plug/Pillar
- Action required:.....

STATION: WALCOTT (Astro) Station No.: 4566
 MAP SHEET SCALE 1:250 000
 INSPECTED BY: D. J. Kain DATE: 19.9.90
 AUTHORITY: L.I.C. FIELD BOOK: CA87

Station Diagram

Not to Scale

North


No Beacon / No SATELLITE MARKS.

STANDPOINT:			
Mark	Direction	Horiz. Distance	Height Difference
			above standpt.
			below standpt.
			above standpt.
			below standpt.
Prepared by: D. KAIN Checked: [Signature] Date: 15/1/90 Note on U.T.M. Card

Checked

Sr 2733-2 D. West, Government Printer

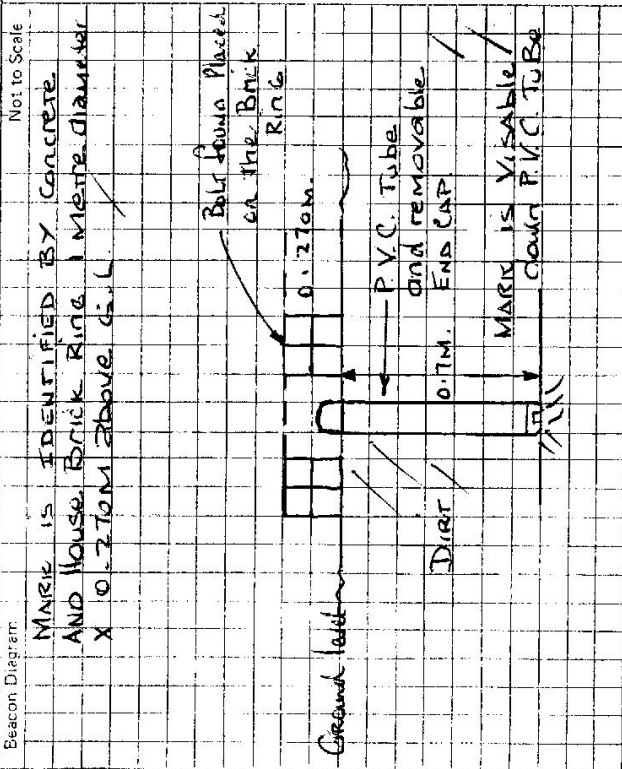

This section to be completed by officer constructing pillar.

Original station mark found/not found.

Description of mark:

Original beacon found/not found.

Description of beacon:

Height Top of Vanes to Top Mark.....m.

Height of mark.....m. above rock/cont.....m. below G.L.


Diameter of Vanes.....m. Height of Cairn.....m.

Original Beacon has/not been destroyed by me.

STATION WALGETT ASTRO Station. TS 4566

Owner's Name: MR. MICK CHAPMAN. Current Occupant: MRS. MRS. CHAPMAN.
 Address: 8 EUKOKA STREET Address:
WALGETT. Phone:
371 Home. Phone:
(068) 281399 Business. ACCESS Phone:
 Access Report of 19.9.90 was found suitable/unsuitable.

WALGETT ASTRO STATION IS SITUATED IN YARD AT REAR OF NO. 8 EUKOKA STREET, WALGETT. ACCESS AND APPROVAL TO VISIT STATION DURING DAYLIGHT BUSINESS HOURS GIVEN BY MRS. LAURIE CHAPMAN. PLEASE CONTACT AND INFORM IF OUTSIDE THESE HOURS.

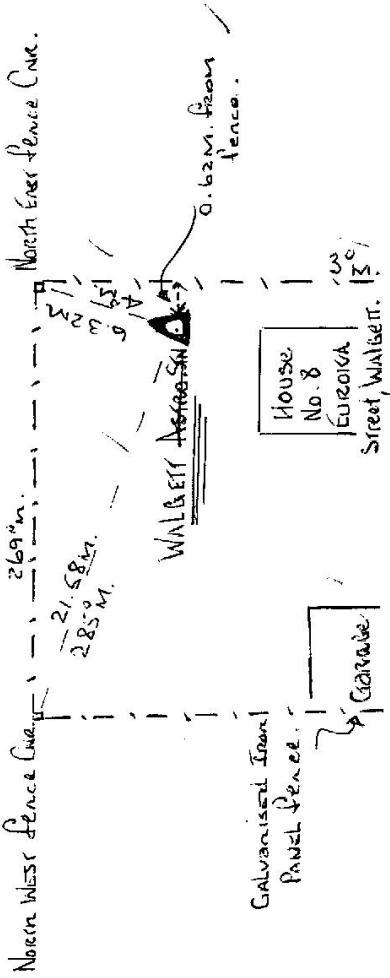

Date	Record of Station