

GEODETIC SURVEY OF N.S.W.

CENTRAL MAPPING AUTHORITY

GEODETIC STATION RECONNAISSANCE and MAINTENANCE REPORT

Description:

1. Cleared by lanes bearing.....  
*Note: Cross out word or words which do not apply*  
 ..... from Trig. Mast
2. ~~Mast & Vanes have been painted white & black, respectively,~~
3. The station/pillar was ~~unplaced~~/~~not unplaced~~/~~constructed~~ on 25<sup>th</sup> February, 1978, dimensions now being:  
 Description of mark..... should be explicit, e.g., S/Steel Pillar Plate, Steel plug, Brass plug, Bolt, G.I. Pipe  
 Height of mark.....m. <sup>above</sup> rock/concrete; Mark is.....m. <sup>above</sup> G.L.  
 Height of Top Vanes to Top Mark/Pillar plate .....m. Diameter of Vanes (vertical).....m.  
 Height of Cairn.....m. Diameter of Cairn.....m. Name Plate found/not found/placed.  
 Length of Mast.....m. (approximate if not unplaced)
4. A..... S.S.M. .... set in conc/rock has been placed/found, bearing.....° M from Mast/~~Plug/Pillar~~
5. A..... set in conc/rock has been placed/found, bearing.....° M from Mast/~~Plug/Pillar~~
6. A..... set in conc/rock has been placed/found, bearing.....° M from Mast/~~Plug/Pillar~~
7. A..... set in conc/rock has been placed/found, bearing.....° M from Mast/~~Plug/Pillar~~
8. Action required: Clearing of timber to South - South West estimated at 1 day

STANDPOINT:

Mark	Direction	Horiz. Distance	Height Difference	Mark	Direction	Horiz. Distance	Height Difference
			above standpt.				above standpt.
			below				below
			above standpt.				above standpt.
			below				below
Prepared by:

Checked:

Noted on U.T.M. Card

SI 2733-1

STATION: WALLABY ROCKS	No.: 4571
MAP SHEET: TAMWORTH SCALE 1:250 000 SH 56-13	WAVERLY 1:31680 9134-III-S
INSPECTED BY: H. P. Jackson	DATE: 25/2/1978
AUTHORITY: Geodetic Survey CMA	FIELD BOOK: 1627

North

Station Diagram

Not to Scale


Checked

CENTRAL MAPPING AUTHORITY  
 GEODETIC SURVEY OF M.S.W.  
 GEODETIC STATION RECONNAISSANCE and MAINTENANCE REPORT

STATION: WALLING ROCKS G.S No.: TS 4571  
 MAP SHEET SCALE: 1:250 000  
 INSPECTED BY: D.J. KHAN DATE: 28 August 1978  
 AUTHORITY: C.M.A. FIELD BOOK: 01653

Description: 1. Cleared by ~~hand~~ <sup>to permit 360° vision</sup> bearing 16 from Trig. Mast  
2. Mast & Vanes have been painted white & black respectively.  
3. The station/~~pillar~~ was unpiled/~~not replaced/reconstructed~~ on 24 <sup>to permit 360° vision</sup> 19.78, dimensions now being: 19.78, dimensions now being: 19.78, dimensions now being: 19.78  
 Description of mark: S/Steel Pipe (should be explicit, e.g., S/Steel Pillar Plate, Steel plug, Brass plug, Bolt, G.I. Pipe)  
 Height of mark: 0.30 m. above ~~concrete~~ <sup>above G.L.</sup> Mark is M m. above G.L.  
 Height of Top Vanes to Top Mark/~~Pillar plate~~ 3.270 m. Diameter of Vanes (vertical) 1 m.  
 Height of Cairn 1.143 m. Diameter of Cairn 1.143 m. Name Plate ~~concrete~~ <sup>concrete</sup> concrete/placed.  
 Length of Mast 3.300 m. (~~approximate if not measured~~)  
 4. A S.S.M. set in conc/~~rock~~ has been ~~placed~~/found, bearing 202° M from ~~Mast/Plug/Pillar~~  
 5. A G.I. Pipe set in conc/~~rock~~ has been placed/found, bearing 339° M from ~~Mast/Plug/Pillar~~  
 6. A G.I. Pipe set in conc/~~rock~~ has been placed/found, bearing 152° M from Mast/Plug/Pillar  
 7. A G.I. Pipe set in conc/~~rock~~ has been placed/found, bearing 152° M from Mast/Plug/Pillar  
 8. Action required: None

STANDPOINT: <u>S/Steel Pipe</u>			STANDPOINT: <u>S.S.M.</u>				
Mark	Direction	Horiz. Distance	Height Difference	Mark	Direction	Horiz. Distance	Height Difference
<u>Mossy Pillar</u>	<u>0 00 00</u>		<u>above</u> standpt.	<u>Mossy Pillar</u>	<u>0 00 00</u>		<u>above</u> standpt.
<u>S.S.M.</u>	<u>51 07 05</u>	<u>3.009</u>	<u>below</u> standpt.	<u>Hexagon Vane</u>	<u>63 87 24 19</u>		<u>above</u> standpt.
<u>Hexagon Vane</u>	<u>87 22 49</u>	<u>3.010</u>	<u>below</u> standpt.	<u>G.I. Pipe</u>	<u>205 04 10 6.470</u>		<u>below</u> standpt.
<u>G.I. Pipe</u>	<u>185 41 19</u>	<u>3.910</u>	<u>above</u> standpt.	<u>S/Steel Pipe</u>	<u>231 10 10 3.010</u>		<u>above</u> standpt.
<u>Prospero Pillar</u>	<u>304 41 26</u>		<u>below</u> standpt.	<u>Prospero Pillar</u>	<u>304 41 26</u>		<u>below</u> standpt.

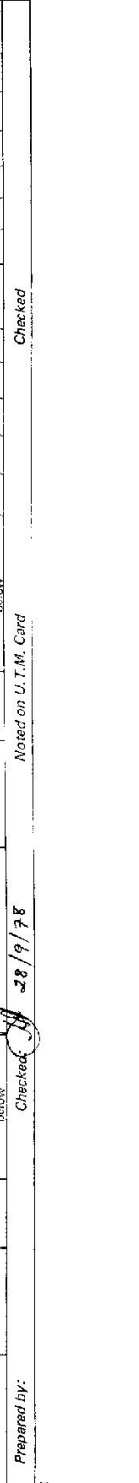


Prepared by: [Signature] 28/9/78  
 Checked: [Signature]  
 Noted on U.T.M. Grid

STATION **MALLING RIVERS G.S. 15 4571**

Owner's Name: **Mr. BANGA CHAIKIN**  
 Address: **Norwood**  
 Phone: **MOONAN FLAT**

Current Occupant: **Mr. John White**  
 Address: **BUNLO**  
 Phone: **MOONAN FLAT 46.3.75**

ACCESS  
 Access Report of 28/19/18 was found suitable/~~unsuitable~~.

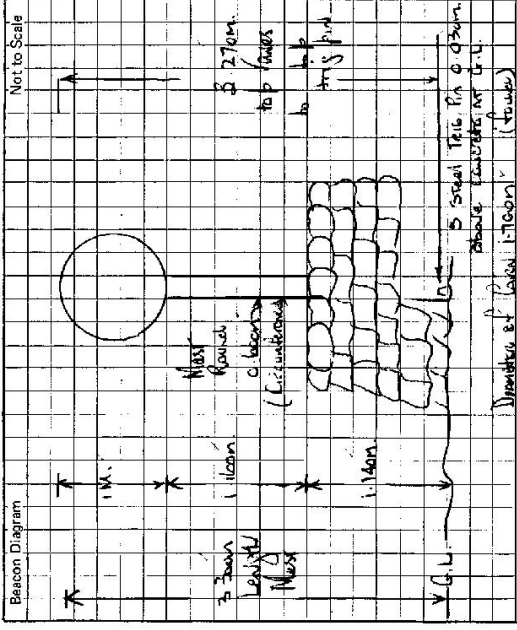

This section to be completed by officer constructing pillar.

Original station mark found/~~not found~~.

Description of mark: **Stainless Steel Iris Pn.**

Original beacon found/~~not found~~.

Description of beacon: **Pole, CAIRN & DISCS**

Height Top of Vanes to Top Mark: **2.71m** above G.L.

Height of mark: **0.20m** above ~~mark/conc~~ **M** below G.L.

Diameter of Vanes: **1.1m** Height of Cairn: **.....m**

Original Beacon ~~has~~ has not been destroyed by me.

Date	Record of Station

Sr 2783-2 D. West, Government Printer SCONE Shire Portion: 148 Parish: Castle Sempill County: BRISBANE

STATION WALLABY ROCKS TS 4571

Beacon Diagram	Not to Scale

Owner's Name: Mr. BARRY QUINN  
 Address: "NORWOOD"  
 MOONAN FLAT  
 Phone: (065) 463175

Manager: Mr. John WHITE,  
 Current Occupant: "BRUMLO"  
 Address: MOONAN FLAT  
 Phone: (065) 463175

ACCESS: From MOONAN FLAT (4 Wheel Drive)

Access Report of 15/2/1988 was found suitable/unsuitable.

Kilometres: Feature:

- 0.0 At MOONAN FLAT Post Office, head South towards SCONE
- 6.4 Cross Grid at end of winding CHALLIS Cutting
- 7.7 Turn Right off MOONAN FLAT - GUNDY Road at Signpost: "45 SCONE" at wooden R.M. Boxes, heading in Northerly direction, fording River at 8.9km
- 9.95 Cross Grid
- 11.2 Pass Track on your Left
- 11.6 Cross Grid, and Grids successively at 12.6 & 13.7km
- 14.1 Pass through double Iron Gates at old R.M.Box.
- 14.4 Take Right Fork in Roads at Signpost: "BRUMLO" passing Signpost & Road to "HIGHLANDS" on your left.
- 15.55 Through double white Iron Gates into "BRUMLO" - Manager's Cottage is 1.75km further along this Road
- 15.8 Turn Right off this Road, heading in a North-easterly direction across brow of spur, down across Gully, and further on to pass through a narrow Iron Gate in a N-S fence, thence heading carefully Eastwards up slope around Contour bank, on up around dry dam onto start of dozed Track up hillside (watch washout here); Continue on up dozed Track as far as possible, park vehicle at suitable turn-around point, then walk South along ridge top around rocky peak for about 30 minutes to WALLABY ROCKS GS at Southern end of Ridge.

This section to be completed by officer constructing pillar.

Original station mark found/not found.

Description of mark: .....

Original beacon found/not found.

Description of beacon: .....

Height Top of Vanes to Top Mark .....m.

Height of mark .....m. above G.L.  
 below rock/conc.....m. below

Diameter of Vanes .....m. Height of Cairn .....m.

Original Beacon has/had not been destroyed by me.

Date	Record of Station