

CENTRAL MAPPING AUTHORITY  
 GEODETIC SURVEY OF N.S.W.

GEODETIC STATION RECONNAISSANCE and MAINTENANCE REPORT

Description:

- Note: Cross out word or words which do not apply
- Cleared by lanes bearing..... from Trig. Mast
  - Mast & Vanes have been painted white & black respectively.
  - The station/pillar was unpiled/not unpiled/constructed on..... 19....., dimensions now being:  
 Description of mark..... should be explicit, e.g., S/Steel Pillar Plate, Steel plug/Brass plug, Bolt, G.I. Pipe  
 Height of mark..... m..... above rock/concrete; Mark is..... m..... above G.L.  
 Height of Top Vanes to Top Mark/Pillar plate..... m..... Diameter of Vanes (vertical)..... m.....  
 Height of Cairn..... m..... Diameter of Cairn..... m..... Name Plate found/not found/placed.  
 Length of Mast..... m..... (approximate if not unpiled)
  - A..... set in conc/rock has been placed/found, bearing.....° M from Mast/Plug/Pillar
  - A..... set in conc/rock has been placed/found, bearing.....° M from Mast/Plug/Pillar
  - A..... set in conc/rock has been placed/found, bearing.....° M from Mast/Plug/Pillar
  - A..... set in conc/rock has been placed/found, bearing.....° M from Mast/Plug/Pillar
  - Action required..... ~~Reconstruct cairn, pole & vanes & clear 20° M~~ ⇒ 40° M

STANDPOINT:

Mark	Direction	Horiz. Distance	Height Difference	Mark	Direction	Horiz. Distance	Height Difference
			above standpt.				above standpt.
			below				below
			above standpt.				above standpt.
			below				below
Prepared by: I.W. Robins 9/2/81 Checked:

Noted on U.T.M. Card *Johnston 2/1/85* Checked


St 2753-1

STATION: WALLAEOI No.: 4575  
 MAP SHEET SCALE 1:250 000 FORBES  
 INSPECTED BY: I.W. Robins DATE: 29/1/81  
 AUTHORITY: C.M.A. FIELD BOOK: 1917

Station Diagram

Not to Scale

6
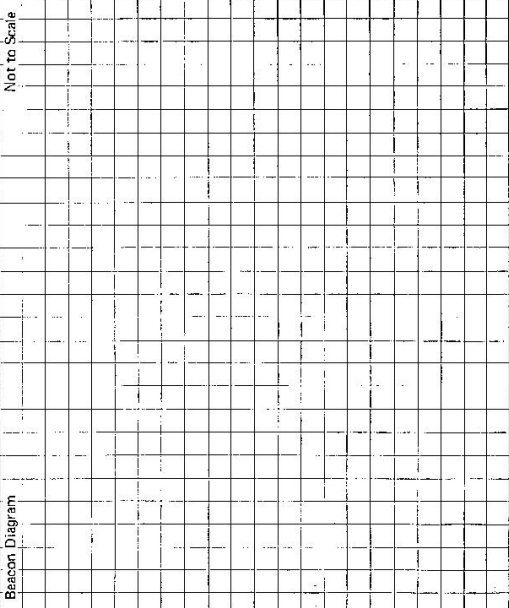
<p>STATION <b>WALLAROI TS 4575</b></p>	<p>Owner's Name: .....                  Address: .....                  Phone: .....</p> <p>Current Occupant: .....                  Address: .....                  Phone: .....</p> <p style="text-align: center;"><u>ACCESS</u></p> <p>Access Report of <b>29.1.1981</b> was found suitable/unsuitable,  <b>NB Condobolin 8331-1 &amp; IV is now published &amp; should be sufficient for access</b></p>
<p>Beacon Diagram</p> <p style="text-align: right;">Not to Scale</p> 	<p>This section to be completed by officer constructing pillar.</p> <p>Original station mark found/not found.</p> <p>Description of mark: .....</p> <p>Original beacon found/not found.</p> <p>Description of beacon: .....</p> <p>Height Top of Vanes to Top Mark .....m.</p> <p>Height of mark .....m. above G.L.                  below</p> <p>Diameter of Vanes .....m. Height of Cairn .....m.</p> <p>Original Beacon has/has not been destroyed by me.</p>
	<p>Date</p> <p style="text-align: right;">Record of Station</p>

CENTRAL MAPPING AUTHORITY

GEODETIC SURVEY OF N.S.W.

GEODETIC STATION RECONNAISSANCE and MAINTENANCE REPORT

Description:

Note: Cross out word or words which do not apply

1. Cleared by ~~tree~~ bearing 260° on 9.4 19.81 dimensions now being: 19.81 from Trig. Mast
2. Mast & Vanes have been painted white & black respectively.
3. The STATION was unplied  
Description of mark BRASS NAIL should be explicit, e.g., S/Steel Pillar Plate, Steel plug, Brass plug, Bolt, G.I. Pipe  
Height of mark 0.041 m. above rock/concrete; Mark is 0.141 m. above G.L.  
Height of Top Vanes to Top Mark 0.03 m. Diameter of Vanes (vertical) 0.754 m.  
Height of Cairn 1.702 m. Diameter of Cairn 2.370 m. Name Plate ~~found~~/not ~~found~~/placed.  
Length of Mast 3.644 m. (approximate if not unplied)
4. A COPPER NAIL set in conc/rock has been placed/~~found~~, bearing 291° M from Mast/Plug/Bolt
5. A G.I. PIPE set in conc/rock has been placed/~~found~~, bearing 219° M from Mast/Plug/Bolt
6. A set in conc/rock has been placed/~~found~~, bearing 151° M from Mast/Plug/Pillar
7. A set in conc/rock has been placed/~~found~~, bearing 151° M from Mast/Plug/Pillar
8. Action required: REPAIR BRASS NAIL

STANDPOINT: BRASS NAIL


STANDPOINT: COPPER NAIL

Mark	Direction	Horiz. Distance	Height Difference	Mark	Direction	Horiz. Distance	Height Difference
<u>CONDOLIN G.S (P)</u>	<u>0 00 00</u>		above standpt.	<u>CONDOLIN G.S (P)</u>	<u>0 00 00</u>		above standpt.
<u>G.I. PIPE</u>	<u>183 04 25</u>	<u>2.918</u>	above standpt.	<u>BRASS NAIL</u>	<u>17 00 42.39</u>	<u>0.033</u>	above standpt.
<u>COPPER NAIL</u>	<u>255 17 30</u>	<u>4.239</u>	below standpt.	<u>G.I. PIPE</u>	<u>114 59 05</u>	<u>4.352</u>	above standpt.
<u>TILCA G.S</u>	<u>345 40 35</u>		above standpt.	<u>TILCA G.S</u>	<u>345 40 45</u>		above standpt.
			below standpt.				below standpt.
			above standpt.				above standpt.
			below standpt.				below standpt.

Prepared by: J.C. Hill

Checked: J.C. Hill

Sr 2733-1

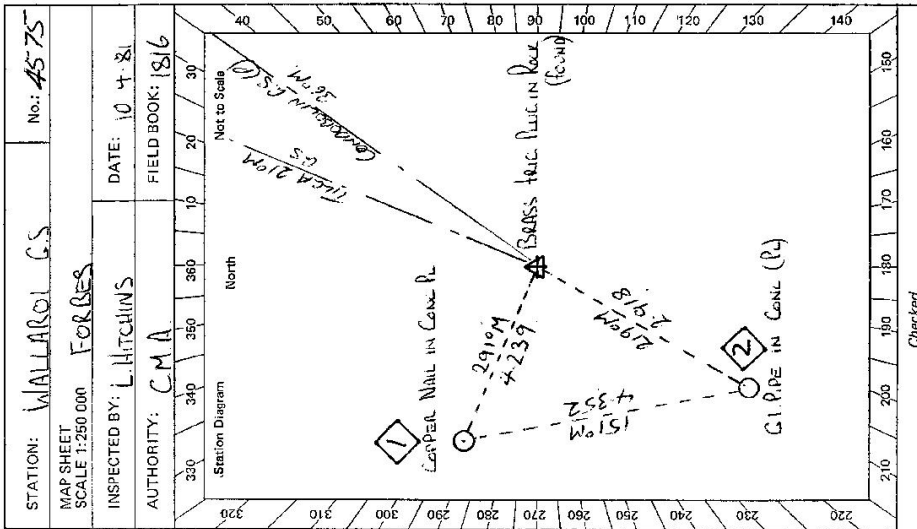

Checked

STATION: WALLAROI G.S No: 4575

MAP SHEET SCALE 1:250 000

INSPECTED BY: L. FITCHINS DATE: 10 4 81

AUTHORITY: CMA FIELD BOOK: 1816

ST 2733-2 D. West, Government Printer Beacon Diagram Not to Scale		This section to be completed by officer constructing pillar. Original station mark found/ <del>not found</del> . Description of mark: <u>BRASS TRAC. PILE</u> Original beacon found/ <del>not found</del> . Description of beacon: <u>CAIRN</u> Height: Top of Vanes to Top Mark ..... m. Height of mark <u>0.047m</u> above rock/ <del>0.160m</del> above G.L. <u>below</u> Diameter of Vanes <u>0.1754</u> m. Height of Cairn <u>1.700</u> m. Original Beacon <del>has</del> /has not been destroyed by me.
STATION WALLAROI G.S TS 4575 Owner's Name: <u>MR. RESERVE</u> Address: <u>CR 23794</u> Phone: <u>0848 957221</u> ACCESS <u>10.4.1981</u>		Access Report of <u>29.1.1981</u> was found <del>in</del> suitable/unsuitable. 0.0 CONDENSOLIN PO HEAD WEST 0.35 TURN LEFT SIGN "WEST WYLONG" 0.75 CROSS BRIDGE 1.8 PASS FORNS RD ON LEFT 2.7 TURN LEFT SIGN WEST WYLONG 16.2 TURN RIGHT SIGN TULLAGH LAKE CAIRN 26.9 TURN RIGHT SIGN "WALLAROI" 30.2 TURN RIGHT 30.35 THROUGH DOUBLE WHITE IRON GATES. 30.95 VEER LEFT AT MAIL BOX SIGN "WALLAROI" 31.7 DAM ON LEFT 32.05 TAKE TRACK TO RIGHT DINNERS HOUSE 32.2 STRAIGHT AHEAD CALL IN- 32.55 VEER LEFT AT FENCE CORNER 32.65 VEER RIGHT AT FENCE THROUGH IRON GATE 33.05 FOLLOW TRACK KEEPING FENCE TO RIGHT *2WD UNTILL 36.25 KM
Owner's Name: <u>MRS. CONNOR BANK CROUCH</u> Address: <u>MARLBOROUGH</u> Phone: <u>0848 957221</u>		33.4 PASS TRACK ON LEFT 33.75 VEER RIGHT THROUGH LEFT HAND IRON GATE 34.3 PASS DAM ON RIGHT 34.65 TURN HARD RIGHT AND FOLLOW WHEEL TRACKS 35.95 CENTRE OF SADDLE VEER RIGHT TO BASE OF HILL *36.25 BASE OF HILL CONTINUE UP HILL IN COUNTERWISE DIRECTION 36.35 STOP TRACK 10 MIN WALK TO G.S.
Date Record of Station		