

CENTRAL MAPPING AUTHORITY

GEODETTIC SURVEY OF N.S.W.
GEODETTIC STATION RECONNAISSANCE and MAINTENANCE REPORT

STATION: **WALLAYA S.S.** No.: **4579**
 MAP SHEET SCALE 1:250 000
 INSPECTED BY: **M.L. Morrison** DATE: **12-1-79**
 AUTHORITY: **C.M.A.** FIELD BOOK: **1720**


Description:
 1. Cleared by lanes bearing.....
 Note: *Cross out word or words which do not apply*

2. Mast & Vanes have been painted white & black respectively.
 3. The station/pillar was unpiled/not unpiled/constructed on.....19..... dimensions now being:
 Description of mark.....should be explicit, e.g., S/Steel Pillar Plate, Steel plug, Brass plug, Bolt, G.I. Pipe
 Height of mark.....m. ^{above} rock/concrete; Mark is.....m. ^{above} G.L.
 Height of Top Vanes to Top Mark/Pillar plate.....m. Diameter of Vanes (vertical).....m.
 Height of Cairn.....m. Diameter of Cairn.....m. Name Plate found/not found/placed.
 Length of Mast.....m. (approximate if not unpiled)
 4. A.....set in conc/rock has been placed/found, bearing.....°M from Mast/Plug/Pillar
 5. A.....set in conc/rock has been placed/found, bearing.....°M from Mast/Plug/Pillar
 6. A.....set in conc/rock has been placed/found, bearing.....°M from Mast/Plug/Pillar
 7. A.....set in conc/rock has been placed/found, bearing.....°M from Mast/Plug/Pillar
 8. Action required:.....

STANDPOINT:

Mark	Direction	Horiz. Distance	Height Difference	Mark	Direction	Horiz. Distance	Height Difference
			above standpt.				above standpt.
			below standpt.				below standpt.
			above standpt.				above standpt.
			below standpt.				below standpt.
Prepared by: *[Signature]* 12/1/79
 Checked: *[Signature]*
 Noted on U.T.M. Card

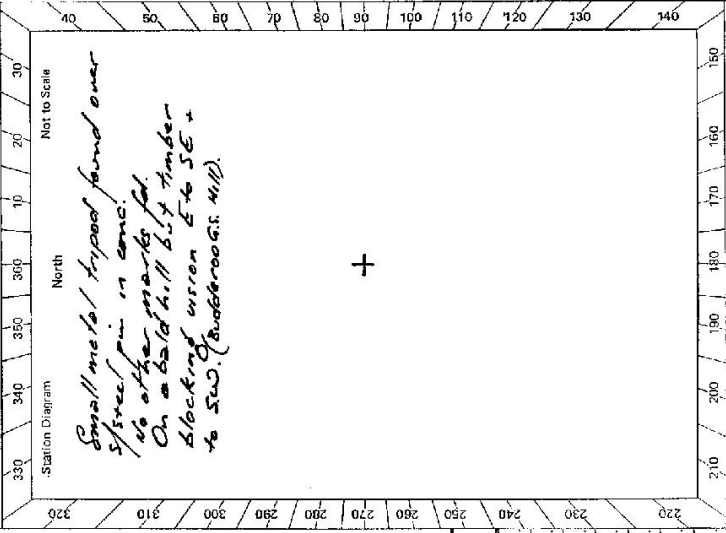

Beacon Diagram Not to Scale 	<table border="1" style="width: 100%; border-collapse: collapse;"> <tr> <td style="width: 30%; vertical-align: top;"> STATION WALLAYA TS 4579 </td> <td style="width: 70%; vertical-align: top;"> Owner's Name: MR M OESTERHAUS Address: Phone: 044) 221107 Current Occupant: Address: Phone: ACCESS 12-1-1979 Access Report etc. of .../19... was found to be (satisfactory/unsatisfactory). Direction: Robinson Rd. Head towards Wollongood Distance: 0.0 Turn: right sign Barren Grounds Nature Reserve Junction: Wamberoo Kiama Pass road to Carrington Falls on right Pass road on left to Knights Hill Turn right off main road. Follow main track. Yards on right. Take track next to yards to top of hill and trig </td> </tr> <tr> <td style="vertical-align: top;"> Date </td> <td style="vertical-align: top;"> Record of Station </td> </tr> </table>	STATION WALLAYA TS 4579	Owner's Name: MR M OESTERHAUS Address: Phone: 044) 221107 Current Occupant: Address: Phone: ACCESS 12-1-1979 Access Report etc. of .../19... was found to be (satisfactory/unsatisfactory). Direction: Robinson Rd. Head towards Wollongood Distance: 0.0 Turn: right sign Barren Grounds Nature Reserve Junction: Wamberoo Kiama Pass road to Carrington Falls on right Pass road on left to Knights Hill Turn right off main road. Follow main track. Yards on right. Take track next to yards to top of hill and trig	Date	Record of Station
STATION WALLAYA TS 4579	Owner's Name: MR M OESTERHAUS Address: Phone: 044) 221107 Current Occupant: Address: Phone: ACCESS 12-1-1979 Access Report etc. of .../19... was found to be (satisfactory/unsatisfactory). Direction: Robinson Rd. Head towards Wollongood Distance: 0.0 Turn: right sign Barren Grounds Nature Reserve Junction: Wamberoo Kiama Pass road to Carrington Falls on right Pass road on left to Knights Hill Turn right off main road. Follow main track. Yards on right. Take track next to yards to top of hill and trig				
Date	Record of Station				
This section to be completed by officer constructing pillar. Original station mark found/not found. Description of mark: Original beacon found/not found. Description of beacon: Height Top of Vanes to Top Mark:m. Height of mark:m. above rock/concm. below G.L. Diameter of Vanes:m. Height of Cairn:m. Original Beacon has/has not been destroyed by me.					