

CENTRAL MAPPING AUTHORITY

GEDDETTIC SURVEY OF N.S.W.


GEDDETTIC STATION RECONNAISSANCE and MAINTENANCE REPORT

STATION: **WANGRAH** No.: **4616**

MAP SHEET SCALE 1:250 000 **CANBERRA**

INSPECTED BY: **G. C. HANNA** DATE: **13 - 8 - 80**

AUTHORITY: **C. M. A.** FIELD BOOK:

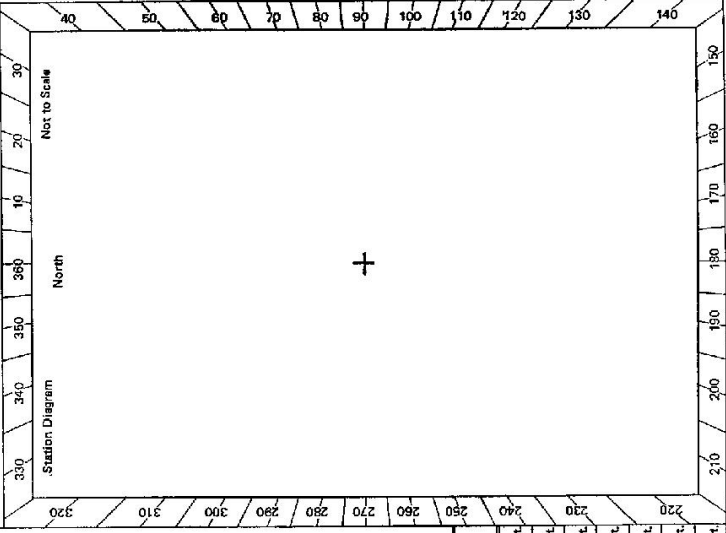

- Description:
- Note: Cross out word or words which do not apply
1. Cleared by lanes bearing..... from ~~Top Mast~~
 2. Mast & Vanes have been painted white & black respectively.
 3. The station/pillar was unpiled/not unpiled/constructed on....., dimensions now being:
 - Description of mark..... should be explicit, e.g., S/Steel Pillar Plate, Steel plug/Brass plug, Bolt, G.I. Pipe
 - Height of mark..... m. ^{above} rock/concrete; Mark is..... m. ^{above} G.L.
 - Height of Top Vanes to Top Mark/Pillar plate..... m. Diameter of Vanes (vertical)..... m.
 - Height of Cairn..... m. Diameter of Cairn..... m. Name Plate found/not found/placed.
 - Length of Mast..... m. (approximate if not unpiled)
 4. A..... set in conc/rock has been placed/found, bearing.....° M from Mast/Plug/Pillar
 5. A..... set in conc/rock has been placed/found, bearing.....° M from Mast/Plug/Pillar
 6. A..... set in conc/rock has been placed/found, bearing.....° M from Mast/Plug/Pillar
 7. A..... set in conc/rock has been placed/found, bearing.....° M from Mast/Plug/Pillar
 8. Action required.....

STANDPOINT:

Mark	Direction	Horiz. Distance	Height Difference	Mark	Direction	Horiz. Distance	Height Difference
			above standpt				above standpt
			below				below
			above standpt				above standpt
			below				below
Prepared by: *Sybilma* 14-8-80 Checked: *W. J. ...* 11/12/80. Noted on U.T.M. Card

