

7.4.88

Trigonometrical Survey of N.S.W.

CENTRAL MAPPING AUTHORITY

Department of Lands

RECONNAISSANCE and MAINTENANCE REPORT

STATION WARRATAH G S. TS 4626

This Trig. Station has been:- Note: Cross out word or words which do not apply

1. Completely cleared to permit 360° vision to surrounding Trigs.
2. Cleared by lanes bearing..... from Trig. Mast
3. Trig. Mast & Vanes have been painted white & black respectively.
4. The Trig. was unpiled/not unpiled, dimensions now being:

Description of mark..... should be explicit, e.g. Steel plug, Brass plug, Bolt, G.I. Pipe
 Height of mark..... m above rock/concrete m above G.L.
 Height of Top Vanes to Top Mark..... m. Diameter of Vanes (vertical)..... m.
 Height of Cairn..... m. Diameter of Cairn..... m.
 Length of Mast..... m. (approximate if not unpiled)

5. A. ~~set~~ ^{approximately} set in conc/rock has been placed. 1.74 m. bearing 250°M from Trig. Mast
6. A. set in conc/soil has been placed..... m. bearing.....°M from Trig. Mast
7. A. set in conc/soil has been placed..... m. bearing.....°M from Trig. Mast
8. A. set in conc/rock has been placed..... m. bearing.....°M from Trig. Mast

9. Connection..... to..... m. bearing.....°M
10. Connection..... to..... m. bearing.....°M
11. Connection..... to..... m. bearing.....°M
12. Connection..... to..... m. bearing.....°M
13. Diff. Ht. ~~approximately~~ ^{approximately} ~~is~~ is 3.62 m. ^{below} TOP OF BUSH POLE
14. Diff. Ht. is..... m. ^{above} below
15. Diff. Ht. is..... m. ^{above} below
16. Diff. Ht. is..... m. ^{above} below

Prepared by: R LANDER Checked: S & T 17 5 77 Noted on U.T.M. Card

Co:

Map Sheet: Katoomba

No: 8930

Inspected by: R. WOODRUFF, R. LANDER


Date: 5-1-77

Authority: CENTRAL MAPPING

Field Book: 151B

Beacon Diagram

Not to Scale

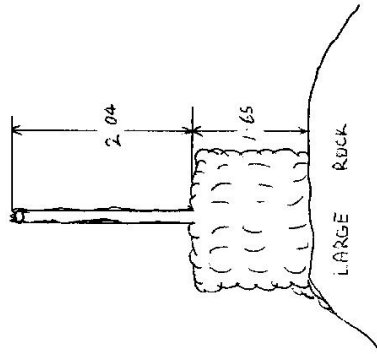

Date

5-1-77

Record of Station

ROTTEN BUSH POLE WITH NO VANES WAS PAINTED WHITE. CLEARED FOR VISION TO CP MOUNTAIN AND MT. HARDS

Checked

