

LAND INFORMATION CENTRE

GEODETIC SURVEY OF N.S.W.

GEODETIC STATION RECONNAISSANCE and MAINTENANCE REPORT

Description:

1. Cleared by lanes bearings. *Note: Cross out word or words which do not apply*  
 (NEEDS CLEARING FOR G.P.S. THESE ARE TWO TOWERS ON HILL)
2. Mast & Vanes have been painted white & black respectively. ✓
3. The station/pillar was unpiled/not unpiled/constructed on..... 19..... dimensions now being:

Description of mark. *PLUG IN ROCK* should be explicit, e.g., S/Steel Pillar Plate, Steel plug, Brass plug, Bolt, G.I. Pipe  
 Height of mark.....m. <sup>above</sup> <sub>below</sub> rock/concrete; Mark is.....m. <sup>above</sup> <sub>below</sub> G.L.  
 Height of Top Vanes to Top Mark/~~Pillar plate~~ .....m. Diameter of Vanes (vertical) *0.750*.....m.  
 Height of Cairn.....m. Diameter of Cairn. *2.4*.....m. Name Plate found/not found/placed.

- Length of Mast.....m. (approximate if not unpiled)
4. A.....set in conc/rock has been placed/found, bearing.....° M from Mast/Plug/Pillar
  5. A.....set in conc/rock has been placed/found, bearing.....° M from Mast/Plug/Pillar
  6. A.....set in conc/rock has been placed/found, bearing.....° M from Mast/Plug/Pillar
  7. A.....set in conc/rock has been placed/found, bearing.....° M from Mast/Plug/Pillar

8. Action required.....

STANDPOINT:				STANDPOINT:			
Mark	Direction	Horiz. Distance	Height Difference	Mark	Direction	Horiz. Distance	Height Difference
			above standpt.				above standpt.
			below				below
			above standpt.				above standpt.
			below				below
Prepared by: *Mal 25/5/95* Checked: *Noted on U.T.M. Card*

STATION: **WARGIN GS** No.: **4641**

MAP SHEET: **CO-TAMINDARA** BORMEDMAY 1: 50,000

INSPECTED BY: **G. FORD** DATE: **16-8-95**

AUTHORITY: **L I C** FIELD BOOK: **---**

STATION **WARGIN C.S 4641**


Owner's Name: .....  
 Current Occupant: .....  
 Address: .....  
 Phone: .....

ACCESS

Access Report of ...../19..... was found suitable/unsuitable.

**0.0 BARMEDMAN PO HEAD NORTH**  
**0.14 TURN LEFT AT HOTELS SIGN BELLARWI**  
**0.61 CROSS RAILWAY LINE**  
**6.14 TURN RIGHT SIGN WARGIN/ BELLARWI**  
**10.06 TURN LEFT SIGN OAKLEIGH**  
**10.86 GRID RAILWAY LINE**  
**11.32 CROSS WIRE GATE**  
**11.35 GRID**  
**12.01 TRIG.**  
**13.12**

Owner's Name: .....  
 Address: .....  
 Phone: .....

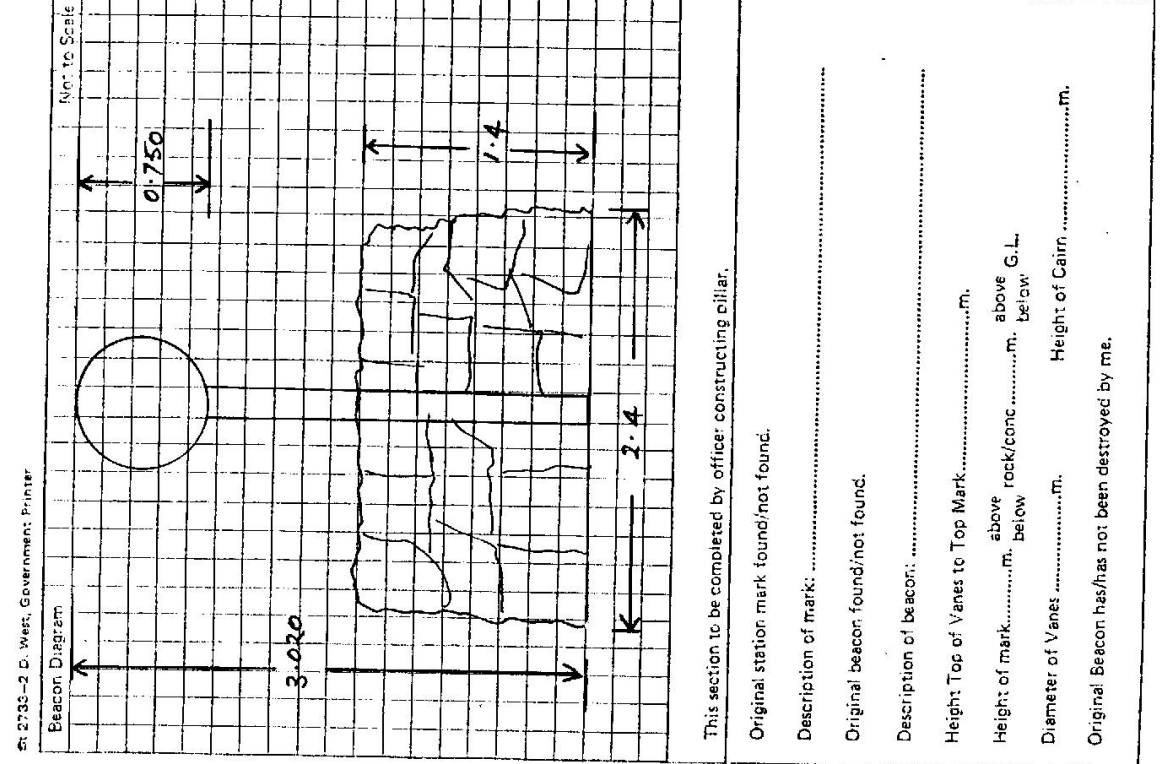

Date	Record of Station