

74-80

CENTRAL MAPPING AUTHORITY
Department of Lands
Trigonometrical Survey of N.S.W.

RECONNAISSANCE and MAINTENANCE REPORT

STATION **WARRAH**

TS **4646**

Co: **NSW** | No: **PA 200/14**
 Map Sheet: **570100 9130 00**
 Inspected by: **P. JACKSON** | Date: **21-5-1975**
 Authority: **C.M.A.** | Field Book: **1447**

Beacon Diagram **Not to Scale**

Steel Roof Top type Pillar

Note: Cross out word or words which do not apply

This Trig. Station has been:

1. Completely cleared to permit 360° vision to surrounding Trigs.
2. Cleared by lanes bearing..... from Trig. Mast
3. Trig. Mast & Vanes have been painted white & black respectively.
4. The Trig. was unpiled/not unpiled, dimensions now being: Original Station Mast (Steel) ~~3~~ feet above ground

Description of mark: ~~Black Plate on Steel Observation Pillar~~ should be explicit, e.g. Steel plug, Brass plug, Bolt, G.I. Pipe

Height of mark..... m ^{above}/_{below} rock/concrete..... m above below G.I.
 Height of Top Vanes to Top Mark..... m. Diameter of Vanes (vertical)..... m.
 Height of Cairn..... m. Diameter of Cairn..... m.

Length of Mast..... m. (approximate if not unpiled)

5. A.D.H. ~~W.A.~~ set in conc/rock has been ^{PILLAR FOUND} placed ~~2.10~~ ^{2.10} m. bearing ~~280~~ ²⁸⁰ °M from Trig. Mast
6. A.D.H. ~~B.A.~~ set in ~~conc/soil~~ ^{rock} has been ~~placed~~ ^{PILLAR FOUND} placed ~~3.374~~ ^{3.374} m. bearing ~~164~~ ¹⁶⁴ °M from Trig. Mast

7. A..... set in conc/soil has been placed..... m. bearing..... °M from Trig. Mast
8. A..... set in conc/rock has been placed..... m. bearing..... °M from Trig. Mast

9. Connection..... to..... m. bearing..... °M

10. Connection..... to..... m. bearing..... °M

11. Connection..... to..... m. bearing..... °M

12. Connection..... to..... m. bearing..... °M

13. Diff. Ht. ~~D.H. W.A.~~ is ~~1.156~~ ^{1.156} m. ~~above~~/_{below} ~~Pillar Plate~~

14. Diff. Ht. ~~D.H. B.A.~~ is ~~1.346~~ ^{1.346} m. ~~above~~/_{below} ~~Pillar Plate~~

15. Diff. Ht. is..... m. ^{above}/_{below}

16. Diff. Ht. is..... m. ^{above}/_{below}

Prepared by: **K.S. JACKSON** Checked: **PO. S. JACKSON**


Noted on U.T.M. Card

Date	Record of Station

Checked

STATION WARRAH TS 4646

Owners Name.....
 Current Occupant.....
 Address.....
 Address.....
 Access.....

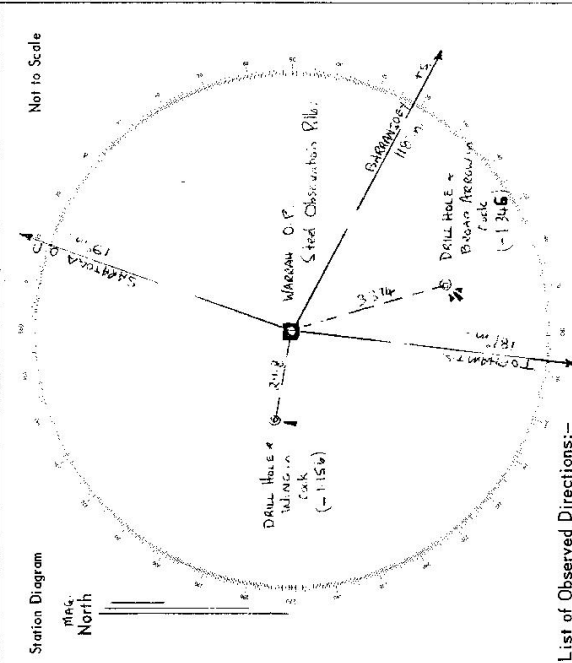

List of Observed Directions:-

Standpoint: Steel Pile		Standpoint: Steel Pile	
Station	Direction	Station	Direction
BARRAMOREE T.S.	357.59 60	TODMAN T.S.	327.59 40
D.H. WARRAH	161.57	BARRAMOREE T.S.	241.11 45
SARATOGA O.P.	266.47 27.5	D.H. BROAD ARROW	336.77

