


STATION WAREHOUSES (P) 4651

Current Occupation

Address


Address

Access 19-5-1975
 Mudgee P.O 0.00 km
 Take road to Lithgow
 Turn right into road
 Signposted "Windsor" 8 km
 Take left fork 19 km.
 Turn right into track
 at gate signposted 21 km.
 "Ingleburn" TS can be seen from road.
 A two wheel drive vehicle
 can be driven to TS

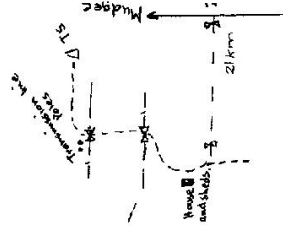

Not to Scale

Station Diagram

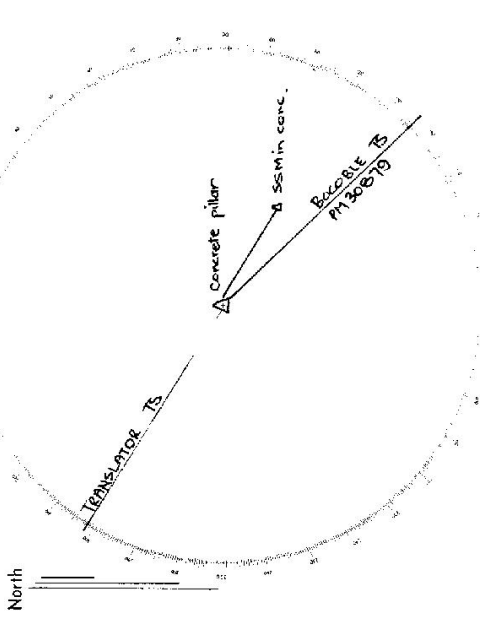

List of Observed Directions:-

| Standpoint: Concrete Pillar | | Standpoint: | |
|-----------------------------|--------------|-------------|-----------|
| Station | Direction | Station | Direction |
| BOCCALE TS (RUR) | 0°00'00" | | |
| PM 30879 | 1°08'29" | | |
| TRANSLATOR TS (RUR) | 174°27'46.8" | | |
| SSM in conc. | 330°31'02" | | |
| Station | Direction | Station | Direction |
| | | | |
| | | | |
| | | | |
| | | | |