

CENTRAL MAPPING AUTHORITY

GEODETIC SURVEY OF N.S.W.

GEODETIC STATION RECONNAISSANCE and MAINTENANCE REPORT

STATION: **WEEWALLION** No.: **A691**

MAP SHEET
SCALE 1:250 000

INSPECTED BY: **L. HIRSHING**

DATE: **8.5.87**

AUTHORITY: **C.M.A.**

FIELD BOOK: **-**

Description:

1. Cleared by lanes bearing ^{1.} to **NARENGARA 3. to JUNGARRE 3. to THORST (215 m)** from Trig. Mast ^(245 m) ^(140 m)

2. Mast & Vanes have been painted white & black respectively. **No**

3. The station ~~pillar was replaced~~ ~~not replaced~~ constructed on ^{1.2.} **UNDULID** 19....., dimensions now being:

Description of mark..... should be explicit, e.g., S/Steel Pillar Plate, Steel plug, Brass plug, Bolt, G.I. Pipe

Height of mark..... m. ^{above} rock/concrete; Mark is..... m. ^{above} G.L. _{below}

Height of Top Vanes to Top Mark/Pillar plate..... m. Diameter of Vanes (vertical)..... m.

Height of Cairn..... m. Diameter of Cairn..... m. ~~Name/Plate found/not found/placed.~~

Length of Mast..... m. (approximate if not unpiled)

4. A..... set in conc/rock has been placed/found, bearing..... °M from Mast/Plug/Pillar

5. A..... set in conc/rock has been placed/found, bearing..... °M from Mast/Plug/Pillar

6. A..... set in conc/rock has been placed/found, bearing..... °M from Mast/Plug/Pillar

7. A..... set in conc/rock has been placed/found, bearing..... °M from Mast/Plug/Pillar

8. Action required: **A. Place Cairn. Be. Note to top (1.000). See Cont. near on base.....**


STANDPOINT:							
Mark	Direction	Horiz. Distance	Height Difference	Mark	Direction	Horiz. Distance	Height Difference
			above				above
			below				below
			standpt.				standpt.
			above				above
			below				below
			standpt.				standpt.
Prepared by: **L.H.**

Checked:

Noted on U.T.M. Card **1587**

Checked

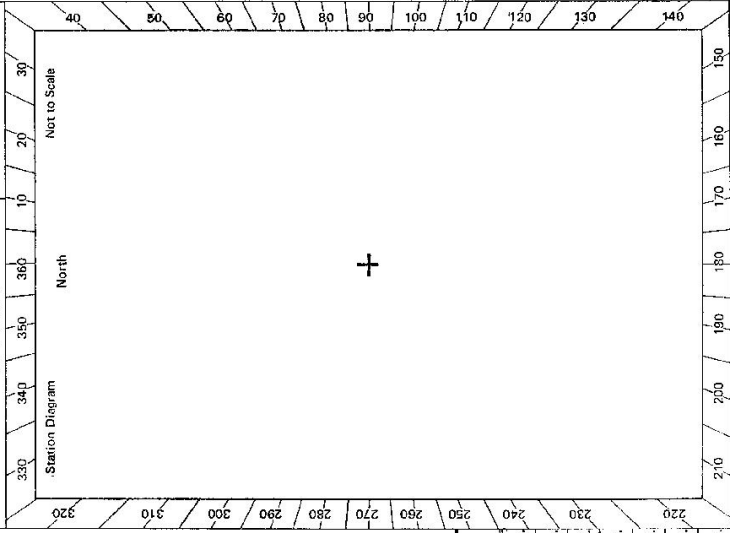

Sr 2735-2 D. West, Government Printer

STATION WEE DALLION IS 4691

Beacon Diagram	Not to Scale

Owner's Name: M. JONES
 Address: FERRIBANK
BUNT VILL WEDNESDAY
 Phone: 833867 AFTER 7PM

Current Occupant: R. WEAVER
 Address:
 Phone:

ACCESS

Access Report of 8.5.1987 was found suitable/unsuitable.

0-0 DRIBBABLE P.O. HEAD EAST
 0-04 TURN RIGHT AROUND PUB
 0-50 TURN LEFT "WARRIP RD"
 0-60 TURN RIGHT ON LEFT "MORNINGWELL RD"
 12-43 PASS ROAD ON RIGHT "9 SHARPS CROSSING"
 14-34 TURN LEFT INTO "FERRIBANK" OWNERS HOUSE,
 15-36 DOUBLE IRON GATES
 15-38 OWNERS HOUSE ON L
 15-40 TAKE TRACK TO R
 15-49 IRON GATE
 15-52 TAKE L FORK
 16-02 THROUGH BOTH IRON GATES. STRAIGHT AHEAD
AS YOU HEAD UP HILL
 16-2 PARK VEHICLE & HEAD TO L UP HILL (15 MINS)
Δ IS WHERE YOU LINE UP WITH FARM ACCESS RD.
DONT DRIVE TOO FAR UP HILL AS OWNER IS
A BIT TETCHY

Date	Record of Station

This section to be completed by officer constructing pillar.

Original station mark found/not found.

Description of mark:

Original beacon found/not found.

Description of beacon:

Height Top of Vanes to Top Markm.

Height of markm. above rock/concm. above G.L.
m. below

Diameter of Vanesm. Height of Cairnm.

Original Beacon has/has not been destroyed by me.