

CENTRAL MAPPING AUTHORITY

Department of Lands

Trigonometrical Survey of N.S.W.

RECONNAISSANCE and MAINTENANCE REPORT

This Trig. Station has been:-

Note: Cross out word or words which do not apply

1. Completely cleared to permit 360° vision to surrounding Trig.
2. Cleared by lanes bearing See diagram from Trig. Mast
3. Trig. Mast & Vanes have been painted white & black respectively.
4. The Trig. was unpiled / not unpiled, dimensions now being:
 - Description of mark..... should be explicit, e.g. Steel plug, Brass plug, Bolt, G.I. Pipe
 - Height of mark..... m above rock/concrete m below G.L.
 - Height of Top Vanes to Top Mark..... m. Diameter of Vanes (vertical) 0.91 m.
 - Height of Cairn 1.6 m. Diameter of Cairn 2 m.
 - Length of Mast 3 m. (approximate if not unpiled)
5. A..... set in conc/rock has been placed..... m. bearing.....°M from Trig. Mast
6. A..... set in conc/soil has been placed..... m. bearing.....°M from Trig. Mast
7. A..... set in conc/soil has been placed..... m. bearing.....°M from Trig. Mast
8. A..... set in conc/rock has been placed..... m. bearing.....°M from Trig. Mast
9. Connection..... to..... m. bearing.....°M
10. Connection..... to..... m. bearing.....°M
11. Connection..... to..... m. bearing.....°M
12. Connection..... to..... m. bearing.....°M
13. Diff. Ht. is..... m. above below
14. Diff. Ht. is..... m. above below
15. Diff. Ht. is..... m. above below
16. Diff. Ht. is..... m. above below


Prepared by: Glenn Jones Checked: _____

Noted on U.T.M. Card

STATION WEISMANTELS T.S. 4697

Co: _____ Ph: _____
 Map Sheet: DUNGOG No: 9233-N
 Inspected by: K. Thompson Date: 23-3-77
 Authority: CMA Field Book: _____

Beacon Diagram Not to Scale

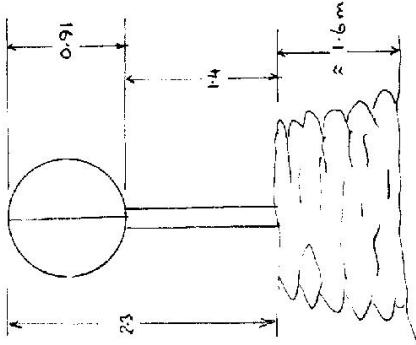

Date	Record of Station

7.4.98

CENTRAL MAPPING AUTHORITY
 Department of Lands
 Trigonometrical Survey of N.S.W.
 RECONNAISSANCE and MAINTENANCE REPORT

STATION **WEDMANTLES** TS **4697**
 Co: **GLoucester** Ph: **A.A. COYE GRANT**
 Map Sheet: **D448208** No: **5233**
 Inspected by: **M.L. HARRISON** Date: **29th SEPT '77**
 Authority: Field Book: **1561**


This Trig. Station has been: *Note: Cross out word or words which do not apply*

1. ~~Completely cleared to permit 360° vision to surrounding Trigs.~~
 2. ~~Cleared by limes-bearing~~ from Trig-Mast
 3. Trig-Mast & Vanes have been painted white & black respectively.
 4. The Trig. was ~~unpiled~~ ^{Original Station Mark not found} should be explicit, e.g. Steel plug, Brass plug, Bolt, G.I. Pipe
- Description of mark m above rock/concrete m above G.L.
 Height of mark m below m below
- Height of Top Vanes to Top Mark m. Diameter of Vane (vertical) **0.91** m.
 Height of Cairn **1.40** m. Diameter of Cairn **1.60** m.
 Length of Mast **5.62** m. (approximate if not unpiled)

5. A. set in conc/rock has been placed m. bearing°M from Trig-Mast
6. A. set in conc/soil has been placed m. bearing°M from Trig-Mast
7. A. set in conc/soil has been placed m. bearing°M from Trig-Mast
8. A. set in conc/rock has been placed m. bearing°M from Trig-Mast
9. Connection to m. bearing°M
10. Connection to m. bearing°M
11. Connection to m. bearing°M
12. Connection to m. bearing°M
13. Diff. Ht. is. m. above below
14. Diff. Ht. is. m. above below
15. Diff. Ht. is. m. above below
16. Diff. Ht. is. m. above below

Prepared by: **M.L. HARRISON** Checked: Noted on U.T.M. Card

Beacon Diagram Not to Scale

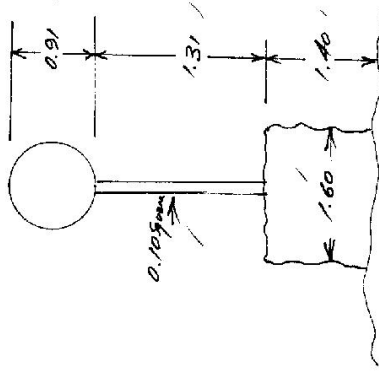

Date	Record of Station
	<i>TRIG. P. IN FAIR CONDITION NEEDS NEW</i>
	<i>MAST HAS BRASS VANES</i>
	<i>NO OTHER MARKS P.</i>
	<i>FOR 1/2 to 1 Day Clearings REQUIRED FOR</i>
	<i>FULL SECTION.</i>
	<i>Permission given to clear hill</i>
	Checked

STATION WEIS MANTIELS TS 4697

Owners Name: Mr. I. G. REELTON

Current Occupant:

Address: ~~Wards~~ WARDS RIVER NO

Address:

Access 25-10-1977

0-0 RAILWAY BRIDGE AT STRAND ROAD

TRAVEL TOWARDS STRAND.

0-7 JOHNSONS CREEK BRIDGE

1-2 TURN LEFT ONTO JOHNSONS CREEK ROAD.

11-1 POWER LINES CROSSES ROAD.

12-5 TURN RIGHT THROUGH IRON GATE.

13-1 TAKE LEFT FORK.

13-5 TRACK CROSSES OLD FENCE.

13-9 LEAVE VEHICLE & WALK UP BADLY WASHED OUT TRACK.


TURN LEFT AT BLAZED TREES FOLLOW BLAZE TO T-S

40 MIN CLIMB

Not to Scale

Station Diagram

North

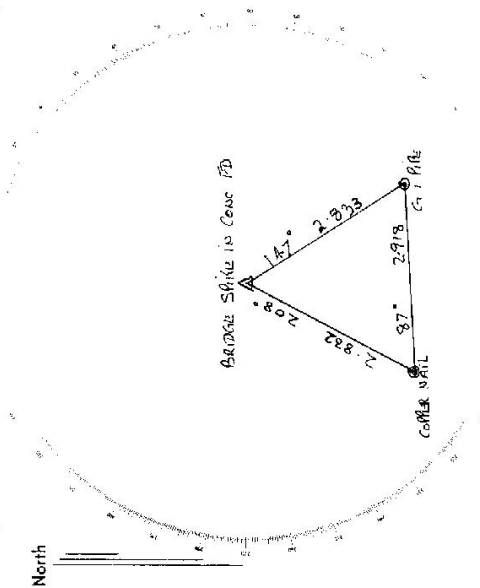

List of Observed Directions:-

Station	Direction	Station	Direction
BRIDGE SPIKE	359.59.40	BLAZED TREES	349.59.60
COPPER NAIL	85.00.50	COPPER NAIL	26.03.05
BRIDGE SPIKE	147.02.55	MONUMENT	207.30.00
COPPER NAIL	207.28.40	BRIDGE SPIKE	327.04.50

Station	Direction	Station	Direction