


CENTRAL MAPPING AUTHORITY
 GEODETTIC STATION RECONNAISSANCE and MAINTENANCE REPORT

STATION: UNDEVELOPED No. TS 4742

MAP SHEET SCALE 1:250 000
 INSPECTED BY: L.L. MULLINS DATE: 16th Feb 1978
 AUTHORITY: UNDEVELOPED FIELD BOOK: 01540

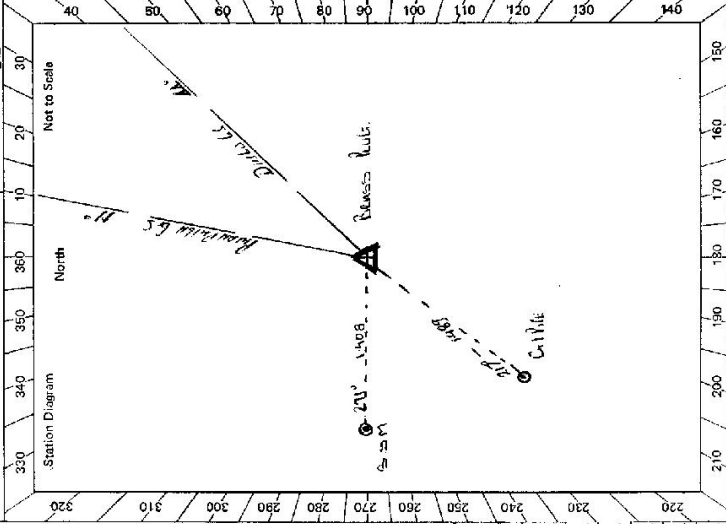

Description:
 Note: Cross out word or words which do not apply

1. Cleared by lanes bearing 210 to 270 from Trig. Mast
2. Mast & Vanes have been painted white & black respectively. ✓
3. The station/~~pillar~~ was unpiled/~~reconstructed~~/constructed on 19 dimensions now being:
 Description of mark Steel Plate, Steel plug, Brass plug, Bolt, G.I. Pipe
 Height of mark 2.50 m. above rock/concrete; Mark is above G.L.
 Height of Top Vanes to Top Mark/~~to top of mark~~ 2.50 m. Diameter of Vanes (vertical) 1.18 m.
 Height of Cairn 1.18 m. Diameter of Cairn 2.50 m. Name Plate ~~found~~ found placed.
4. A S.S.M. set in cone/~~rock~~ has been placed/found, bearing 271° M from ~~Mast/Plug/Pillar~~
5. A Cairn set in ~~rock~~ has been placed/found, bearing 217° M from ~~Mast/Plug/Pillar~~
6. A S.S.M. set in cone/~~rock~~ has been placed/found, bearing 271° M from ~~Mast/Plug/Pillar~~
7. A S.S.M. set in cone/~~rock~~ has been placed/found, bearing 271° M from ~~Mast/Plug/Pillar~~
8. Action required: None

STANDPOINT: <u>BRASS PILE</u>		STANDPOINT: <u>S.S.M.</u>	
Mark	Direction	Mark	Direction
<u>Business R.L.</u>	<u>0 00 00</u>	<u>Business R.L.</u>	<u>0 00 00</u>
<u>Cairn</u>	<u>23 24 00</u>	<u>Cairn</u>	<u>23 24 00</u>
<u>G.I. Pipe</u>	<u>200 00 55</u>	<u>Business R.L.</u>	<u>56 35 1909</u>
<u>S.S.M.</u>	<u>260 50 10</u>	<u>Cairn</u>	<u>143 28 35 1981</u>

Prepared by: David 214 Checked: David 214
 Noted on U.T.M. Card

