

GEODETTIC SURVEY OF M.S.W.

CENTRAL MAPPING AUTHORITY


**GEODETTIC STATION RECONNAISSANCE and MAINTENANCE REPORT**

STATION: **S.M.A. 759** No.: **477**

MAP SHEET SCALE 1:250 000 **TANTANGARA 100,000**

INSPECTED BY: **R. COOK** DATE: **7-3-74**

AUTHORITY: **C.M.A.** FIELD BOOK:

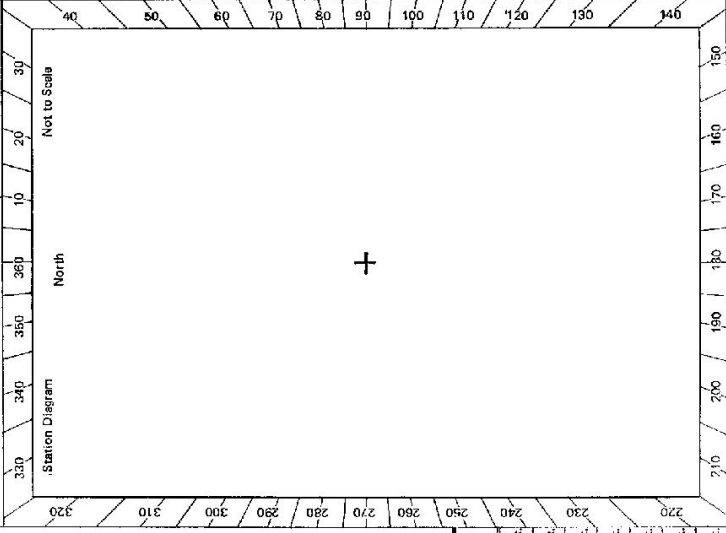


- Description:
- Note: Cross out word or words which do not apply*
- Cleared by lanas bearing..... from Trig. Mast
  - Mast & Vanes have been painted white & black respectively.
  - The station/pillar was unpiled/not unpiled/constructed on..... 19....., dimensions now being: **Brass Plug**
  - Description of mark..... should be explicit, e.g., S/Steel Pillar Plate, Steel plug, Brass plug, Bolt, G.I. Pipe
  - Height of mark..... m. above rock/concrete; Mark is..... m. above below G.I.
  - Height of Top Vanes to Top Mark/Pillar plate ..... m. Diameter of Vanes (vertical)..... m.
  - Height of Cairn..... m. Diameter of Cairn..... m. Name Plate found/not found/placed.
  - Length of Mast ..... m. (approximate if not unpiled)
  - A..... set in conc/rock has been placed/found, bearing..... M from Mast/Plug/Pillar
  - A..... set in conc/rock has been placed/found, bearing..... M from Mast/Plug/Pillar
  - A..... set in conc/rock has been placed/found, bearing..... M from Mast/Plug/Pillar
  - A..... set in conc/rock has been placed/found, bearing..... M from Mast/Plug/Pillar

Action required: **Good... conditional... surrounded by light timber... Priv. to trig.....**

STANDPOINT:			
Mark	Direction	Horiz. Distance	Height Difference
			above standpt.
			below
			above standpt.
			below
Prepared by: **Rodney Cook** Checked: **Noted on U.T.M. Card**

Ss: 2753-2 D. West, Government Printer

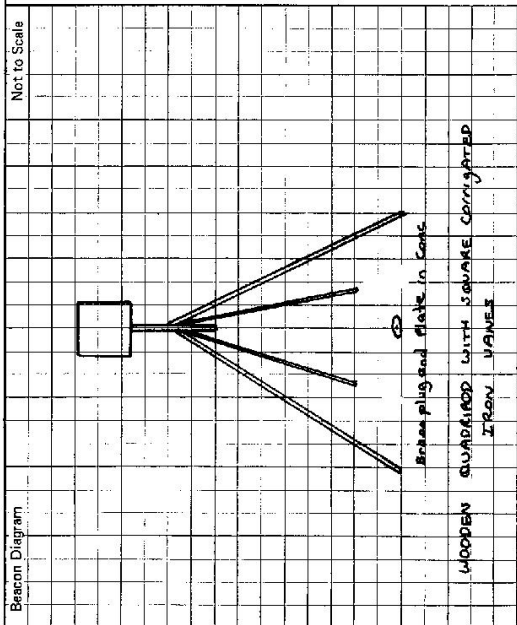

This section to be completed by officer constructing pillar.

Original station mark found/not found.

Description of mark: .....

Original beacon found/not found.

Description of beacon: .....

Height Top of Vanes to Top Mark.....m.

Height of mark.....m. above G.L. below

Diameter of Vanes .....m. Height of Cairn .....m.

Original Beacon has/has not been destroyed by me.

STATION <b>S.M.A. 759 TS 477</b>	Current Occupant: ..... Address: ..... Phone: .....  Owner's Name: ..... Address: <i>Situated within the KARAWIRO NATIONAL PARK.</i> Phone: .....  ACCESS Access Report of 7.7.79: <i>1972 was found suitable/unsuitable.</i>
Date <b>7-3-79</b>	Record of Station <i>Recommencement of P. Trig during field completion of Tantangara 1:25,000 Access Taken off the Tantangara 1:25,000 Provisional</i>