

CENTRAL MAPPING AUTHORITY

GEODETIC SURVEY OF N.S.W.


GEODETIC STATION RECONNAISSANCE and MAINTENANCE REPORT

STATION: *Nelson* No: *4786*

MAP SHEET SCALE 1:250 000 *Canberra*

INSPECTED BY: *Pt. Bamola* DATE: *May 78*

AUTHORITY: *CMA* FIELD BOOK:

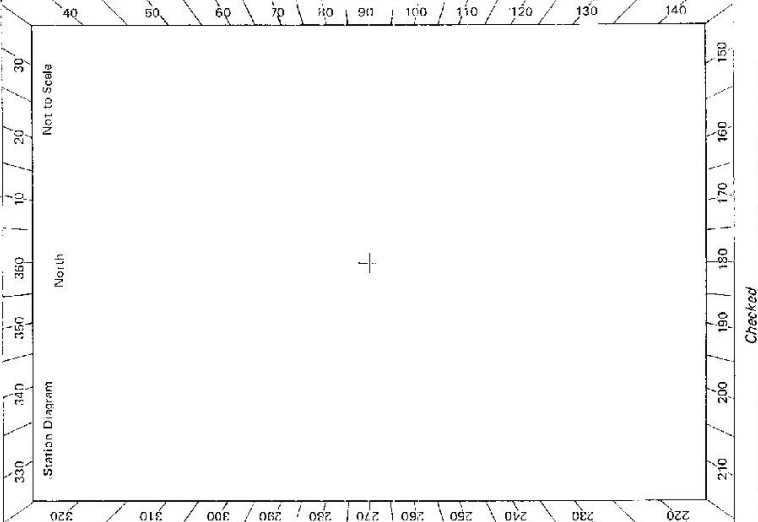

Description:

1. Cleared by lanes bearing.....
Note: Cross out word or words which do not apply
2. Mast & Vanes have been painted white & black respectively. In case of rocks found.
3. The station/pillar was unpiled/not unpiled/constructed on....., 19....., dimensions now being:
Description of mark.....should be explicit, e.g., S/Steel Pillar Plate, Steel plug, Brass plug, Boll, G.I. Pipe
Height of mark.....m, above rock/concrete; Mark is.....m, above G.L.
Height of Top Vanes to Top Mark/Pillar plate.....m. Diameter of Vanes (vertical).....m.
Height of Cairn.....m. Diameter of Cairn.....m. Name Plate found/not found/placed.
Length of Mast.....m. (approximate if not unpiled)
4. A.....set in conc/rock has been placed/found, bearing.....°M from Mast/Plug/Pillar
5. A.....set in conc/rock has been placed/found, bearing.....°M from Mast/Plug/Pillar
6. A.....set in conc/rock has been placed/found, bearing.....°M from Mast/Plug/Pillar
7. A.....set in conc/rock has been placed/found, bearing.....°M from Mast/Plug/Pillar
8. Action required: *Station Suitable for Pillar Construction*

STANDPOINT:			
Mark	Direction	Horiz. Distance	Height Difference
			above standpt.
			below standpt.
			above standpt.
			below standpt.
Prepared by: *Subman* Checked: *Subman* Note on U.T.M. Grid

GS

STATION *Wilson T.S. 4786*

Owner's Name: Address: <i>Corolo Property</i> Phone:	Current Occupant: Address: Phone:	ACCESS Access Report of <i>May 1978</i> / 19..... was found suitable/unsuitable. <i>Refer Taemas Bridge 8627-1-N</i> <i>"Corolo" property follow track leading south for approx 3.2 km. (on southern side of fence) then follow fence heading west for approx 400 m. then follow fence heading south/on east side of the fence to the T.S.</i>
Date		Record of Station

Beacon Diagram	Not to Scale
This section to be completed by officer constructing pillar. Original station mark found/not found. Description of mark: Original beacon found/not found. Description of beacon: Height Top of Vanes to Top Mark m. Height of mark m. above G.L. below m. Diameter of Vanes m. Height of Cairn m. Original Beacon has/has not been destroyed by me.	