


STATION WINGECARRIBEE G.S. (PILLAR) TS 4802

Owners Name.....
 Current Occupant.....
 Address.....
 Address.....
 Access.....

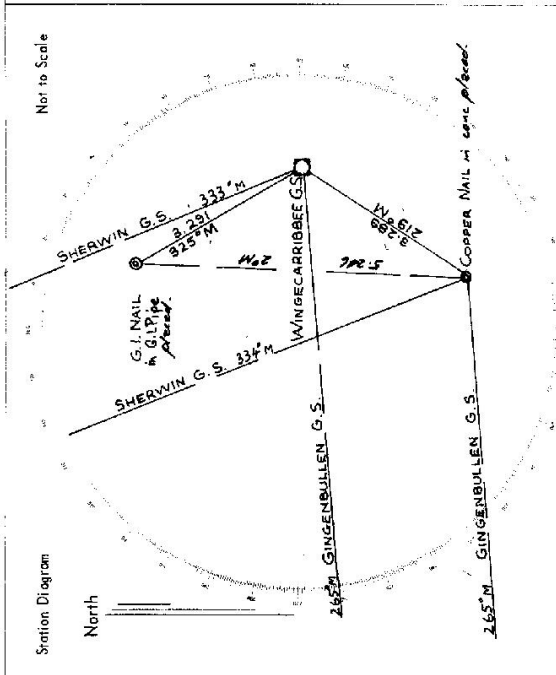

List of Observed Directions:-

Standpoint: OBSERVING PILLAR		Standpoint: COPPER NAIL in cone placed	
Station	Direction	Station	Direction
GINGEBULLEN G.S.	352° 59' 60"	GINGEBULLEN G.S.	302° 52' 60"
G.I. NAIL IN G.I. PIPE IN CONC.	60° 11' 10"	SHERWIN G.S.	63° 45' 30"
SHERWIN G.S.	69° 45' 00"	G.I. NAIL IN G.I. PIPE IN CONC.	97° 18' 30"
COPPER NAIL IN CONC.	314° 26' 25"	OBSERVING PILLAR	334° 28' 00"
<i>Trig. Peg Found</i>		<i>Copper Nail in cone placed</i>	
Station	Direction	Station	Direction
GINGEBULLEN G.S.	359° 59' 60"	GINGEBULLEN G.S.	359° 59' 60"
G.I. Nail in G.I. Pipe in Conc.	60° 10' 00"	SHERWIN G.S.	69° 45' 10"
SHERWIN G.S.	63° 45' 10"	G.I. Nail in G.I. Pipe in Conc.	97° 18' 10"
Copper nail in cone placed	314° 25' 20"	Trig. Peg in rock found	114° 25' 10"