

7-0-99

CENTRAL MAPPING AUTHORITY
Department of Lands

Trigonometrical Survey of N.S.W.

RECONNAISSANCE and MAINTENANCE REPORT

STATION WINNS HILL

TS 4805

This Trig. Station has been:-

Note: Cross out word or words which do not apply

1. Completely cleared to permit 240° vision to surrounding Trig.

2. Cleared by lances bearing see drawing from Trig. Mast

3. Trig-Mast & Vanees have been painted white & black respectively.

4. The Trig. was ~~unpiled~~/not unpiled, dimensions now being: should be explicit, e.g. Steel plug, Brass plug, Bolt, G.I. Pipe

Description of mark..... m above below rock/concrete..... m above below G.L.

Height of Top Vanes to Top Mark..... m. Diameter of Vanes (vertical)..... m.

Height of Cairn..... m. Diameter of Cairn..... m.

Length of Mast..... m. (approximate if not unpiled)

5. A. G.I. pipe set in conc/rock has been placed found 3.7 m. bearing 340°M from Trig-Mast old blaze in tree stump

6. A..... set in conc/soil has been placed..... m. bearing.....°M from Trig. Mast

7. A..... set in conc/soil has been placed..... m. bearing.....°M from Trig. Mast

8. A..... set in conc/rock has been placed..... m. bearing.....°M from Trig. Mast

9. Connection..... to..... m. bearing.....°M

10. Connection..... to..... m. bearing.....°M

11. Connection..... to..... m. bearing.....°M

12. Connection..... to..... m. bearing.....°M

13. Diff. Ht. is..... m. above below

14. Diff. Ht. is..... m. above below

15. Diff. Ht. is..... m. above below

16. Diff. Ht. is..... m. above below

Prepared by: John J. O'Connell Checked: Noted on U.T.M. Card

Co: Ph:

Map Sheet: BULLMIDELAH

Inspected by: K. Thompson

Authority:

Beacon Diagram

Not to Scale

No beacon.


Date	Record of Station

Checked

STATION WINNS HILL TS 4805


Owners Name:
Current Occupant:
Address:
Address: 21/3/1977

Access o/c At BULDERM R.D. travel north along Stroud St. thru shopping centre.
1-4 — travel straight on at signposts "Markwell 6, Upper Myall B, Cabbage Tree Nth 17".
5-4 — cross over concrete bridge.
5-8 — leave sealed road and take gravel road on left. (Green house on RHS of gravel Rd.)
9-2 — cross concrete causeway. take right gravel road up mountain.
16-0 — take left hand track. Sign says "Bull Forest Rd."
21-2 — take left fork, (off Bull Forest Rd.)
23-1 — take right fork. main track, sign says "Jarrah Rd."
23-8 — left along main track.
24-8 — straight ahead. Saggars Ck trail on right.
25-3 — blaze in tree on RHS of track. (see below)

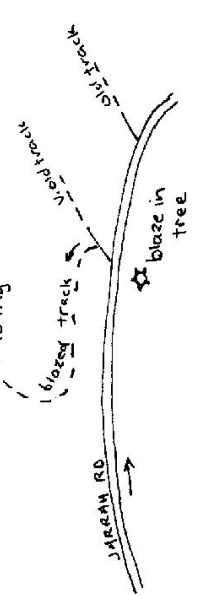

- from blaze in tree track is followed as shown above. involves 10 min steep walk. or may be negotiated in 4x4 if some clearing done along old logging track to trig
- track is blazed to top of ridge where old blaze in tree stump found.

Station Diagram Magnetic North

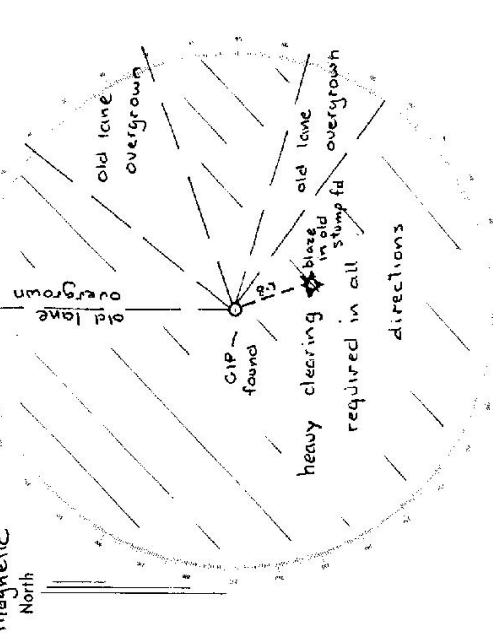

List of Observed Directions:-

Standpoint:	
Station	Direction
Station	Direction