

CENTRAL MAPPING AUTHORITY

STATION: WINTER No.: 4806

MAP SHEET SCALE 1:250 000 CANIBERRA

INSPECTED BY: G. C. HANNA DATE: 23/4/79

AUTHORITY: C.M.A. FIELD BOOK:

FIELD BOOK:

Not to Scale

Station Diagram

North

+

320 310 300 290 280 270 260 250 240 230 220

330 340 350 360 370 380 390 400 410 420 430 440

210 200 190 180 170 160 150

Checked

320 310 300 290 280 270 260 250 240 230 220

330 340 350 360 370 380 390 400 410 420 430 440

210 200 190 180 170 160 150

Checked

GEODETIC STATION RECONNAISSANCE and MAINTENANCE REPORT

Description:

1. Cleared by lanes bearing..... Note: Cross out word or words which do not apply

2. Mast & Vanes have been painted white & black respectively.

3. The station/pillar was unplugged/not unplugged/constructed on..... 19..... dimensions now being:

Description of mark..... should be explicit, e.g., S/Steel Pillar Plate, Steel plug-Brass plug, Bolt, G.I. Pipe

Height of mark..... m. above rock/concrete; Mark is..... m. above G.L.

Height of Top Vanes to Top Mark/Pillar plate..... m. Diameter of Vanes (vertical)..... m.

Height of Cairn..... m. Diameter of Cairn..... m. Name Plate found/not found/placed.

Length of Mast..... m. (approximate if not unplugged)

4. A..... set in conc/rock has been placed/found, bearing..... ° M from Mast/Plug/Pillar

5. A..... set in conc/rock has been placed/found, bearing..... ° M from Mast/Plug/Pillar

6. A..... set in conc/rock has been placed/found, bearing..... ° M from Mast/Plug/Pillar

7. A..... set in conc/rock has been placed/found, bearing..... ° M from Mast/Plug/Pillar

8. Action required.....

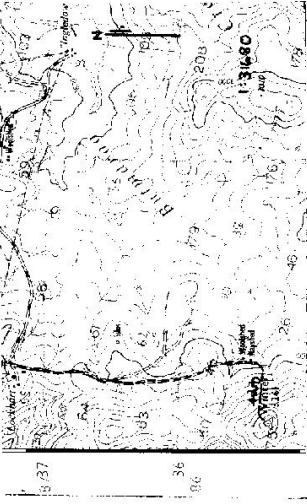
STANDPOINT:

Mark	Direction	Horiz. Distance	Height Difference	Mark	Direction	Horiz. Distance	Height Difference
			above standpt.				above standpt.
			below				below
			above standpt.				above standpt.
			below				below
Prepared by: G. Hanna 8/5/79

Checked: Noted on U.T.M. Card

G:

81 2753-2 D West, Government Printer Beacon Diagram	STATION <b>WINTER</b> TS 4806	<p>Owner's Name: .....                  Address: .....                  Phone: .....</p> <p>Current Occupant: .....                  Address: .....                  Phone: .....</p> <p style="text-align: center;"><b>ACCESS</b></p> <p>Access Report of ...../19.....was found suitable/unsuitable.</p> <div style="text-align: center; margin-top: 20px;"> <p><b>Cairn only found</b>  <b>No clearing required</b>  <b>Drive to.</b></p> <p><b>Bungendore Abt 12km</b></p> </div>  <p style="margin-top: 20px;">For further information see:                  Manar 8827 - III - N</p>
Not to Scale		<p>This section to be completed by officer constructing pillar.</p> <p>Original station mark found/not found.</p> <p>Description of mark: .....</p> <p>Original beacon found/not found.</p> <p>Description of beacon: .....</p> <p>Height Top of Vanes to Top Mark:.....m.                  above                  below</p> <p>Height of mark.....m. above                  rock/cont.....m. below G.L.</p> <p>Diameter of Vanes.....m.      Height of Cairn.....m.</p> <p>Original Beacon has/hus not been destroyed by me.</p>
Date		
Record of Station		..... ..... ..... .....