

CENTRAL MAPPING AUTHORITY

GEODETIC SURVEY OF NSIK

GEODETIC STATION RECONNAISSANCE and MAINTENANCE REPORT

Description:

1. Cleared by lanes bearing. *Note: Cross out word or words which do not apply*

2. Mast & Vanes have been painted white & black respectively.

3. The station/pillar was unpiled/not unpiled/constructed on.....19....., dimensions now being:

Description of mark.....should be explicit, e.g., S/Steel Pillar Plate, Steel plug, Brass plug, Bolt, G.I. Pipe

Height of mark.....m. ^{above}/_{below} rock/concrete; Mark is.....m. ^{above}/_{below} G.L.

Height of Top Vanes to Top Mark/Pillar plate.....m. Diameter of Vanes (vertical).....m.

Height of Cairn.....m. Diameter of Cairn.....m. Name Plate found/not found/placed.

Length of Mast.....m. (approximate if not unpiled)

4. A.....set in conc/rock has been placed/found, bearing.....°M from Mast/Plug/Pillar

5. A.....set in conc/rock has been placed/found, bearing.....°M from Mast/Plug/Pillar

6. A.....set in conc/rock has been placed/found, bearing.....°M from Mast/Plug/Pillar

7. A.....set in conc/rock has been placed/found, bearing.....°M from Mast/Plug/Pillar

8. Action required: ~~MARK~~ ~~SET~~ ~~IN~~ ~~THE~~ ~~FIELD~~ ~~...~~ ~~SITUATED~~ ~~ON~~ ~~THE~~ ~~SPARE~~ ~~OF~~ ~~THE~~ ~~RISE~~ ~~...~~

STANDPOINT:

Mark	Direction	Horiz. Distance	Height Difference	Mark	Direction	Horiz. Distance	Height Difference
			above standpt				above standpt
			below				below
			above standpt				above standpt
			below				below
Prepared by: *Rudney Cook* Checked: *[Signature]*

Noted on U.T.M. Card


ST 2733-1

STATION: **S. M. A. 763** No.: **481**
 MAP SHEET SCALE 1:250 000 **TANTANGARA** 1:100,000
 INSPECTED BY: **R. COOK** DATE: **8-3-79**
 AUTHORITY: **C. M. A.** FIELD BOOK:


Station Diagram
 North
 Not to Scale

GS 24

STATION **S.M.A. 763 TS 481**

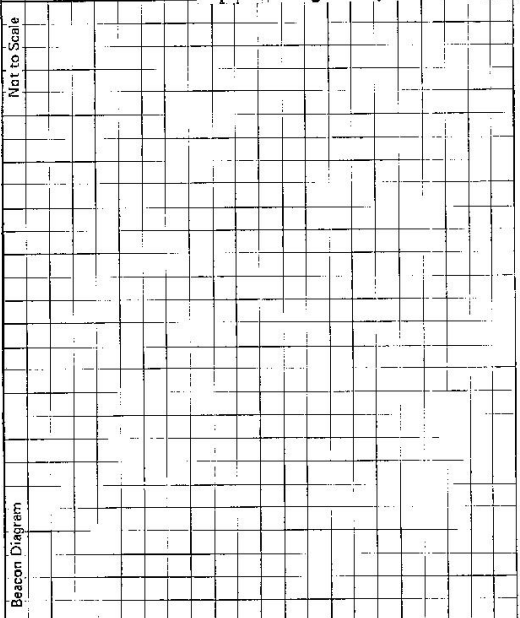

Owner's Name:
 Address: **Situated with the KOSCIUSKO NATIONAL PARK**
 Phone:
 Current Occupant:
 Address:
 Phone:

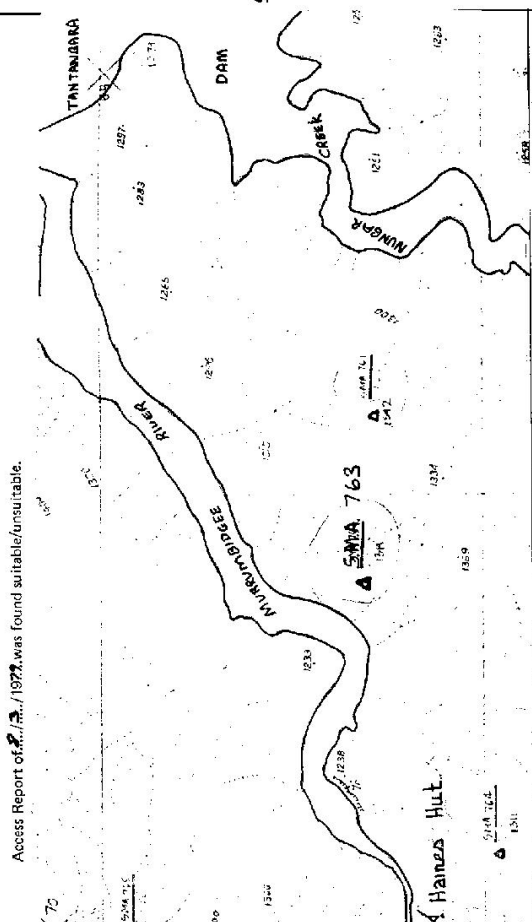

ACCESS
 Access Report of 27/10/1977 was found suitable/unsuitable.

This section to be completed by officer constructing pillar.
 Original station mark found/not found.
 Description of mark:
 Original beacon found/not found.
 Description of beacon:
 Height Top of Vanes to Top Markm.
 Height of markm. above G.L. below G.L.
 Diameter of Vanesm. Height of Cairnm.
 Original Beacon has/has not been destroyed by me.

Date	Record of Station
8-3-79	Reconnaissance ref. Trig during field completion of Tantangara 1:25,000 Access Taken off the Tantangara 1:25,000 Provisional.