

GEODETTIC SURVEY OF N.S.W.

CENTRAL MAPPING AUTHORITY

GEODETTIC STATION RECONNAISSANCE and MAINTENANCE REPORT

Description:

1. Cleared by lances bearing $325^\circ - 215'$ Note: Cross out word or words which do not apply
 $242^\circ - 248'$ from Trig. Mast
2. Mast & Vanes have been painted white & black respectively. ✓
3. The station/pillar was unpiled/not unpiled/constructed on 19 dimensions now being:
 Description of mark **BRASS PLUG** should be explicit, e.g., S/Steel Pillar Plate, Steel plug, Brass plug, Bolt, G.I. Pipe
 Height of mark 0.077 m. ^{above} ~~rock~~/concrete; Mark is m. ^{above} below G.L.
 Height of Top Vanes to Top Mark/Pillar plate m. Diameter of Vanes (vertical) m.
 Height of Cairn m. Diameter of Cairn m. Name Plate found/not found/placed.
 Length of Mast m. (approximate if not unpiled)
4. A. **COPPER NAIL** set in conc/rock has been placed/found, bearing 270° M from Mast/Plug/Pillar
5. A. **G.I. PIPE** set in conc/rock has been placed/found, bearing 173° M from Mast/Plug/Pillar
6. A. set in conc/rock has been placed/found, bearing M from Mast/Plug/Pillar
7. A. set in conc/rock has been placed/found, bearing M from Mast/Plug/Pillar
8. Action required:


STANDPOINT: BRASS TRIG PLUG				STANDPOINT: COPPER NAIL			
Mark	Direction	Horiz. Distance	Height Difference	Mark	Direction	Horiz. Distance	Height Difference
WOLGAN GAP P.	$359^\circ 59' 60''$	✓	above standpt.	WOLGAN GAP P.	$359^\circ 59' 60''$	✓	above standpt.
G.I. PIPE	$359^\circ 54' 10''$	2.305	above standpt.	WOLGAN TRIG PLUG	$276^\circ 14' 00''$	2.056	above standpt.
COPPER NAIL	$96^\circ 14' 00''$	2.056	below	G.I. PIPE	$321^\circ 01' 15''$	3.257	above standpt.
BRASS ROCK P.	$323^\circ 55' 00''$	✓	above standpt.	BRASS ROCK P.	$323^\circ 55' 25''$	✓	above standpt.
			below				below
			above standpt.				above standpt.
			below				below
			above standpt.				above standpt.
			below				below

Prepared by:

Checked: **W.F. 19-12-78**

Noted on U.T.M. Card

Checked

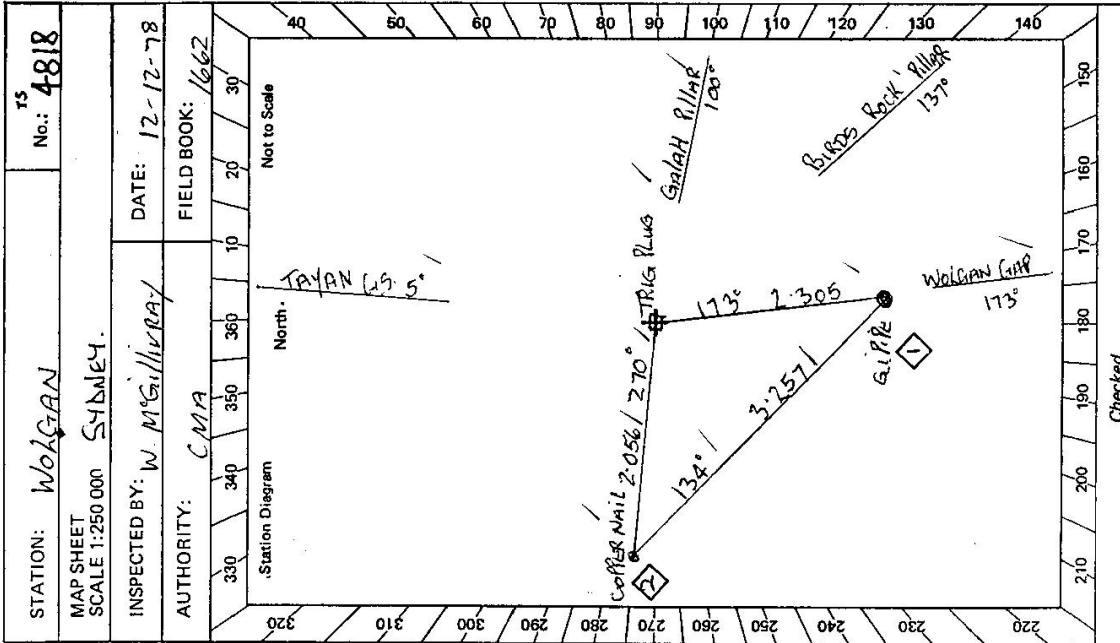

STATION: **WOLGAN** No.: **4818**

MAP SHEET SCALE 1:250,000 **SYDNEY**

INSPECTED BY: **W. Mc Gillivray** DATE: **12-12-78**

AUTHORITY: **CMA** FIELD BOOK: **1662**

