

GEODETTIC SURVEY OF N.S.W.

CENTRAL MAPPING AUTHORITY


GEODETTIC STATION RECONNAISSANCE and MAINTENANCE REPORT

- Description:**
 Note: Cross out word or words which do not apply
 1. Cleared by lanes bearing, ~~Timbered~~ **360°** ~~63-270° M. light timber~~ from Trig. Mast easily cleared.
 2. Mast & Vanees have been painted white & black respectively, mast in partly dismantled cairn. No vanes
 3. The station/pillar was ~~replaced~~/not unplaced/constructed on.....19....., dimensions now being:
 Description of mark.....should be explicit, e.g., S/Steel Pillar Plate, Steel plug, Brass plug, Bolt, G.I. Pipe
 Height of mark.....m. ^{above} rock/concrete; Mark is.....m. ^{above} G.L.
 Height of Top Vanes to Top Mark/Pillar plate.....m. Diameter of Vanes (vertical).....m.
 Height of Cairn.....m. Diameter of Cairn.....m. Name Plate ~~found~~/not found/~~placed~~.
 Length of Mast.....m. (approximate if not unplaced)
 4. A.....set in conc/rock has been placed/found, bearing.....°M from Mast/Plug/Pillar
 5. A.....set in conc/rock has been placed/found, bearing.....°M from Mast/Plug/Pillar
 6. A.....set in conc/rock has been placed/found, bearing.....°M from Mast/Plug/Pillar
 7. A.....set in conc/rock has been placed/found, bearing.....°M from Mast/Plug/Pillar
 8. Action required:.....**G.O.U.B.O.R.N.**
 1: 25000

| STANDPOINT: | | | |
|-------------|-----------|-----------------|-------------------|
| Mark | Direction | Horiz. Distance | Height Difference |
| | | | above standpt. |
| | | | below standpt. |
| | | | above standpt. |
| | | | below standpt. |
Prepared by: *[Signature]* Checked: *[Signature]*
 Noted on U.T.M. Card

8: 2788-1

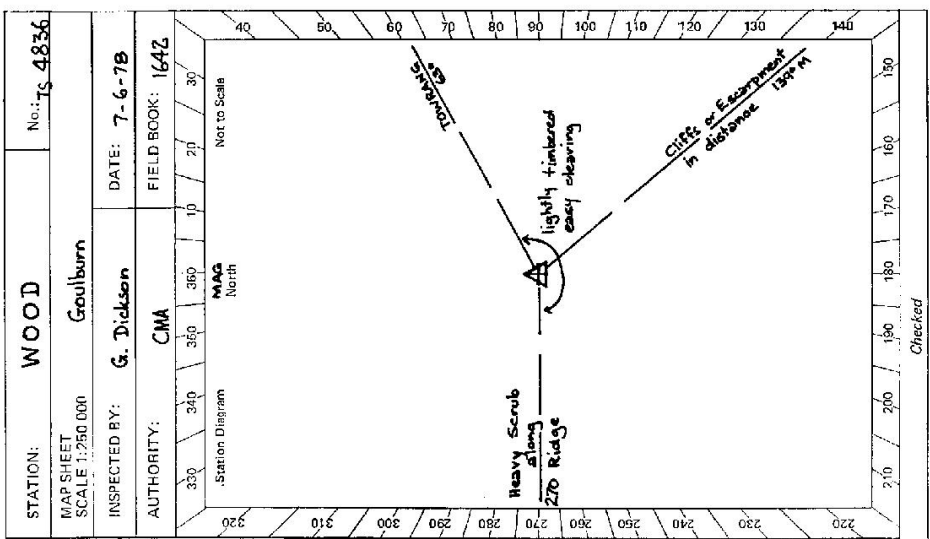

CENTRAL MAPPING AUTHORITY

GEODETIC SURVEY OF N.S.W.

GEODETIC STATION RECONNAISSANCE and MAINTENANCE REPORT

- Description: *Note: Cross out word or words which do not apply*
1. Cleared by lanes bearing..... *1.1m bearing 340°* from Trig. Mast
 2. Mast/Vanes have been painted ~~with black~~ *Rep. led* ~~with black~~ *white* respectively.
 3. The station/pillar was ~~constructed~~ *Repl. led* ~~constructed~~ *Repl. led* on *1.3m x 1.1m* ~~19.24m~~ *19.24m*, dimensions now being: Description of mark..... *Repl. led* ~~19.24m~~ *19.24m*, should be explicit, e.g., S/Steel Pillar Plate, Steel plug, Brass plug, Bolt, G.I. Pipe
Height of mark..... *0.4m* ~~above rock/concrete~~ *above* ~~rock/concrete~~ *rock/concrete*; Mark is *A.T.* ~~above~~ *above* ~~G.L.~~ *G.L.*
Height of Top Vanes to Top Mark/Pillar plate *1.07m* ~~1.07m~~ *1.07m*. Diameter of Vanes (vertical)..... *1.07m*
Height of Cairn..... *0.4m*. Diameter of Cairn..... *0.2m*. Name Plate ~~found/not found/placed~~.
Length of Mast..... *0.4m* (approximate if not supplied)
 4. A..... *I.S.D. Pillar* set in conc/rock has been placed/found, bearing..... *114°* ~~0°~~ *114°* M from Mast/Plug/Pillar
 5. A..... *D.M.R. MARKS* set in conc/rock has been placed/found, bearing..... *130°* ~~0°~~ *130°* M from Mast/Plug/Pillar
 6. A..... set in conc/rock has been placed/found, bearing..... *0°* ~~0°~~ *0°* M from Mast/Plug/Pillar
 7. A..... set in conc/rock has been placed/found, bearing..... *0°* ~~0°~~ *0°* M from Mast/Plug/Pillar
 8. Action required:.....


STANDPOINT:.....

| Mark | Direction | Horiz. Distance | Height Difference | Mark | Direction | Horiz. Distance | Height Difference |
|------|-----------|-----------------|-------------------|------|-----------|-----------------|-------------------|
| | | | above standpt. | | | | above standpt. |
| | | | below standpt. | | | | below standpt. |
| | | | above standpt. | | | | above standpt. |
| | | | below standpt. | | | | below standpt. |
Prepared by: *D. J. Kain*

Checked:.....

Noted on U.T.M. Card

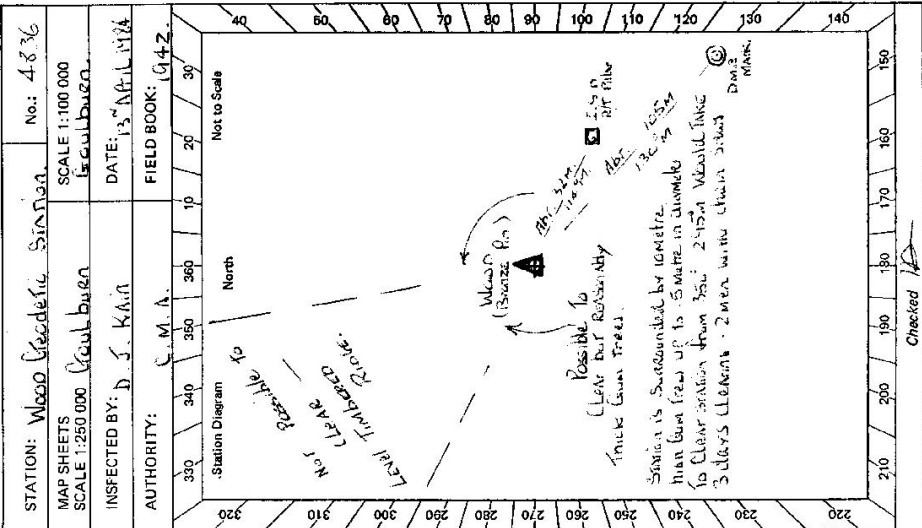

Checked: *D. J. Kain*

FIELD BOOK: *1942*

STATION: *Wood Geodetic Station* No: *4836*

MAP SHEETS SCALE 1:100 000

SCALE 1:250 000 *Geulbuen*

INSPECTED BY: *D. J. Kain* DATE: *13 April 1974*

AUTHORITY: *C.M.A.*

