

GEODETTIC SURVEY OF N.S.W.

CENTRAL MAPPING AUTHORITY

GEODETTIC STATION RECONNAISSANCE and MAINTENANCE REPORT

Description:

Note: Cross out word or words which do not apply

1. Cleared by lanes bearing..... from Trig, Mast
2. Mast & Vanes have been painted white & black respectively.
3. The station/pillar was unpiled/not unpiled/constructed on.....19..... dimensions now being:
 - Description of mark.....should be explicit, e.g. S/Steel Pillar Plate, Steel plug, Brass plug, Bolt, G.I. Pipe
 - Height of mark.....m. ^{above} _{below} rock/concrete; Mark is.....m. ^{above} _{below} G.L.
 - Height of Top Vanes to Top Mark/Pillar platem. Diameter of Vanes (vertical).....m.
 - Height of Cairn.....m. Diameter of Cairn.....m. Name Plate found/not found/placed.
 - Length of Mast.....m. (approximate if not unpiled)

4. A.....set in conc/rock has been placed/found, bearing.....°M from Mast/Plug/Pillar
5. A.....set in conc/rock has been placed/found, bearing.....°M from Mast/Plug/Pillar
6. A.....set in conc/rock has been placed/found, bearing.....°M from Mast/Plug/Pillar
7. A.....set in conc/rock has been placed/found, bearing.....°M from Mast/Plug/Pillar

8. Action required: *Overhead collapsed. NO MARKS. WAS EXPOSED. SURROUNDED BY HEAVY TIMBER. I SAW WALK TO TRIG.*

STANDPOINT:

Mark	Direction	Horiz. Distance	Height Difference	Mark	Direction	Horiz. Distance	Height Difference
			above standpt.				above standpt.
			below standpt.				below standpt.
			above standpt.				above standpt.
			below standpt.				below standpt.
			above standpt.				above standpt.
			below standpt.				below standpt.
			above standpt.				above standpt.
			below standpt.				below standpt.

Prepared by: *R. Cook* Checked: *[Signature]*

ST 2733-1

Noted on U.T.M. Card

STATION: **S.M.A. 766** No.: **484**


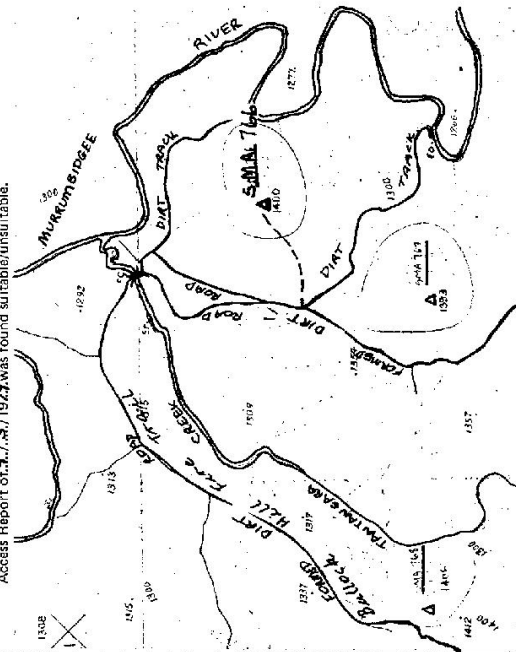
MAP SHEET SCALE 1:250 000 **TANTANGARA** 1:100,000

INSPECTED BY: **R. COOK** DATE: **9-3-79**

AUTHORITY: **C.M.A.** FIELD BOOK:

North

Not to Scale

6: 2733-2 D. West, Government Printer	STATION	S.M.A. 766 TS 484
Owner's Name: Address: <i>Subitted within the</i> <i>K. P. S. S. N. K. M. N. M. N. M. N. M. N. M. N. M. N. M. N.</i> Phone:		Current Occupant: Address: Phone:
ACCESS Access Report of <i>1.7/1922</i> was found suitable/unsuitable.		NORTH  Scale 1: 25,000
		Record of Station Date: <i>9-3-79</i> <i>Recessional distance of Top marking field completion of Trantayanga 1:25,000</i> <i>Access taken off the pantayanga 1:25,000 revisional.</i>
This section to be completed by officer constructing pillar. Original station mark found/not found. Description of mark: Original beacon found/not found. Description of beacon: Height Top of Vanes to Top Markm. Height of markm. above /below G.L. Diameter of Vanesm. Height of Cairnm. Original Beacon has/has not been destroyed by me.		

Beacon Diagram		Not to Scale
----------------	--	--------------