

CENTRAL MAPPING AUTHORITY
Department of Lands

Trigonometrical Survey of N.S.W.

RECONNAISSANCE and MAINTENANCE REPORT

STATION WOOLPACK

TS 4849

This Trig. Station has been:-

Note: Cross out word or words which do not apply

Co: Beresford Ph: Wisc

Map Sheet: No:

Inspected by: G.R. HISSEY Date: May '77

Authority: SOIL CONSERVATION SERVICE Field Book:

Beacon Diagram Not to Scale

1. ~~Completely cleared to permit 360° vision to surrounding Trig.~~

2. Cleared by lanes bearing 283° , 350° , 90° from Trig. Mast

3. Trig. Mast & Vanes have been painted white & black respectively.

4. The Trig. was unpiled/~~not supplied~~, dimensions now being: ~~Original Station Mast found ~~undisturbed~~~~

Description of mark: Drill hole in concrete should be explicit, e.g. Steel plug, Brass plug, Bolt, G.I. Pipe

Height of mark: m above rock/concrete m below G.L.

Height of Top Vanes to Top Mark: 3.74 m. Diameter of Vanes (vertical): 1.01 m.

Height of Cairn: m. Diameter of Cairn: m.

Length of Mast: 3.74 m. (approximate if not unpiled)

5. A. ~~set in conc/rock has been placed~~ m. bearing ~~9M from Trig. Mast~~

6. A. set in conc/soil has been placed m. bearing 9M from Trig. Mast

7. A. set in conc/soil has been placed m. bearing 9M from Trig. Mast

8. A. set in conc/rock has been placed m. bearing 9M from Trig. Mast

9. Connection to m. bearing 9M

10. Connection to m. bearing 9M

11. Connection to m. bearing 9M

12. Connection to m. bearing 9M

13. Diff. Ht. is m. above below

14. Diff. Ht. is m. above below

15. Diff. Ht. is m. above below

16. ~~Diff. Ht.~~ is m. above below

Prepared by:

Checked:

Noted on U.T.M. Card

Checked

Date


Record of Station

STATION WOOLPACK TS 4849

Owners Name
 Current Occupant.....
 Address.....
 Address.....

Access May 1977

4 Wheel Drive Only Access difficult in damp times - See Mr. B.A. Russ, "Little Tinderry" ANEMBO - Michelago Road

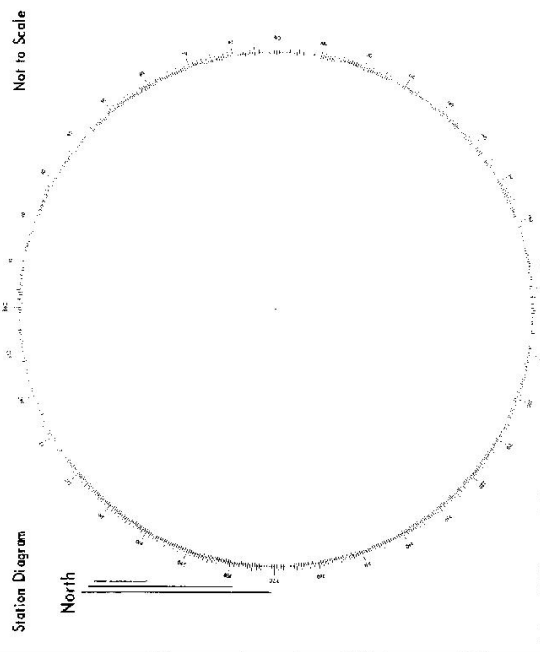

List of Observed Directions:-

Standpoint:	
Station	Direction
Standpoint:	
Station	Direction

