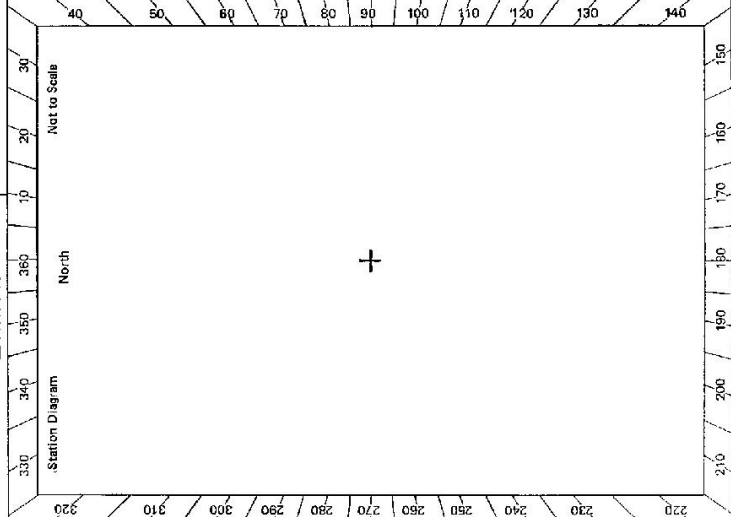


GEODETTIC SURVEY OF NSAK

CENTRAL MAPPING AUTHORITY

GEODETTIC STATION RECONNAISSANCE and MAINTENANCE REPORT

STATION: **S.M.A. 767** No.: **485**
 MAP SHEET SCALE 1:250 000 **TANTANGARA 1: 100,000**
 INSPECTED BY: **R. COOK** DATE: **4-3-79**
 AUTHORITY: **C.M.A.** FIELD BOOK:

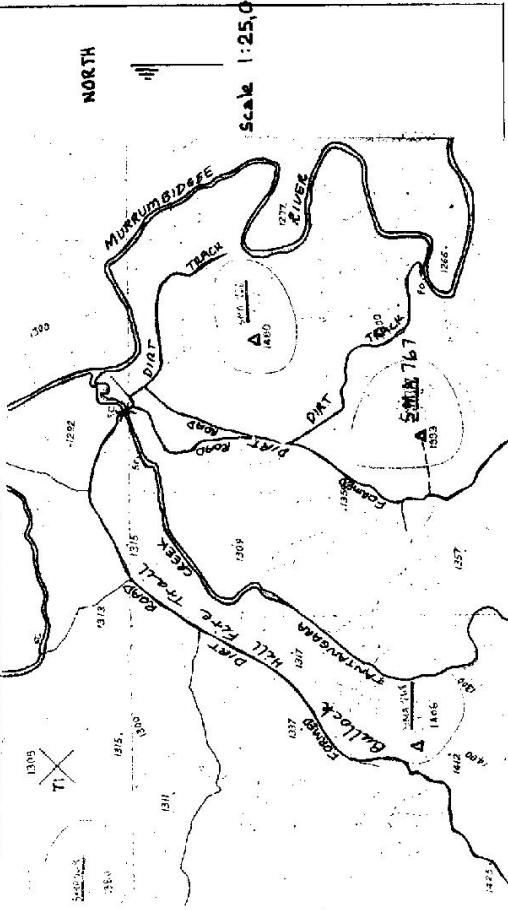
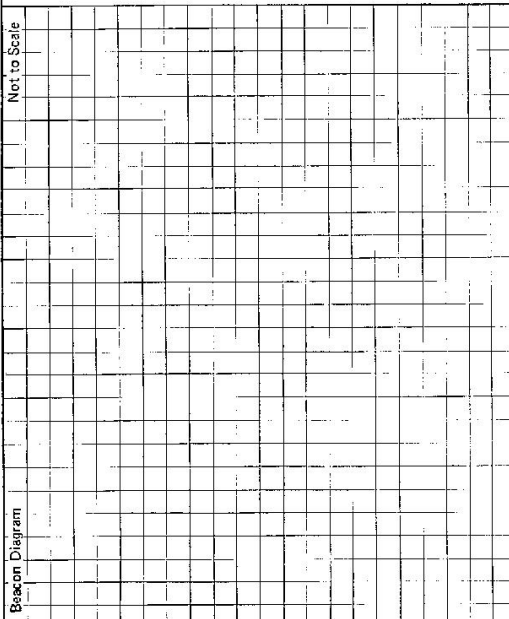


- Description: *Note: Cross out word or words which do not apply*
- Cleared by lanes bearing..... from Trig, Mast
 - Mast & Vanes have been painted white & black respectively.
 - The station/pillar was unpiled/not unpiled/constructed on.....19....., dimensions now being:
 Description of mark **G.I. Nail**..... should be explicit, e.g., S/Steel Pillar Plate, Steel plug, Brass plug, Bolt, G.I. Pipe
 Height of mark.....m, above below rock/concrete; Mark is.....m, above below G.I.
 - Height of Top Vanes to Top Mark/Pillar platem. Diameter of Vanes (vertical).....m.
 Height of Cairn.....m. Diameter of Cairn.....m. Name Plate found/not found/placed.
 Length of Mast.....m. (approximate if not unpiled)
 - A.....set in conc/rock has been placed/found, bearing.....°M from Mast/Plug/Pillar
 - A.....set in conc/rock has been placed/found, bearing.....°M from Mast/Plug/Pillar
 - A.....set in conc/rock has been placed/found, bearing.....°M from Mast/Plug/Pillar
 - A.....set in conc/rock has been placed/found, bearing.....°M from Mast/Plug/Pillar
 - Action required: **Round top collapsed. Surrounded by light timbered drive. To**.....

STANDPOINT:				STANDPOINT:			
Mark	Direction	Horiz. Distance	Height Difference	Mark	Direction	Horiz. Distance	Height Difference
			above standpt				above standpt
			below standpt				below standpt
			above standpt				above standpt
			below standpt				below standpt
Prepared by: **Rodney Cook** Checked: **Checked**
 Noted on U.T.M. Card

GS

STATION S.M.A. 767 IS 485	Owner's Name: Address: <i>Situated within the KOSCIUSKO NATIONAL PARK</i> Phone:	Current Occupant: Address: Phone:	Access Report of <i>9.3.79</i> was found suitable/unavailable. 
Beacon Diagram Not to Scale 	This section to be completed by officer constructing pillar. Original station mark found/not found. Description of mark: Original beacon found/not found. Description of beacon: Height Top of Vane to Top Markm. Height of markm. above G.L. below Diameter of Vanem. Height of Cairnm. Original Beacon has/has not been destroyed by me.		
Date 9.3.79	Record of Station <i>Reconstruction of Trig. during field completion of Tambarunga 1:25,000 Access taken off the Tambarunga 1:25,000 revisional.</i>		

Sr: 2733-2 D. West: Government Printer