

CENTRAL MAPPING AUTHORITY

GEODETIC SURVEY OF N.S.W.


GEODETIC STATION RECONNAISSANCE and MAINTENANCE REPORT

- Description:
- Cleared by lances bearing..... 60°..... 120 M..... 160°..... 90 M..... 244°..... 251 M..... from Trig. Mast
 Note: Cross out word or words which do not apply
 - Mast & Vanes have been painted white & black respectively. ✓ 17-5-79 INEQUITY 24 D. PARSELY (6/1/79)
 - The station/attar was unpiled/~~not unpiled~~ on..... 25 M..... 137.4..... dimensions now being:
 Description of mark.....
 Height of mark..... 0.220 m..... above rock/concrete; Mark is..... 8.0..... m..... below G.L.
 Height of Top Vanes to Top Mark/Pillar Plate 3.850 m..... Diameter of Vanes (vertical)..... 0.610 m.....
 Height of Cairn..... 0.150 m.....
 Length of Mast..... 2.810 m..... (approximate if not supplied) ON TRIG VANES
 - A..... S.S.M..... set in conc/rock has been placed/found, bearing..... 253°..... from Mast/Plug/Pillar
 - A..... G.I. pipe, set in conc/rock has been placed/found, bearing..... 172°..... from Mast/Plug/Pillar
 - A..... set in conc/rock has been placed/found, bearing..... °M from Mast/Plug/Pillar
 - A..... set in conc/rock has been placed/found, bearing..... °M from Mast/Plug/Pillar
 - Action required:.....

STANDPOINT:		STANDPOINT:		STANDPOINT:			
Mark	Direction	Horiz. Distance	Height Difference	Mark	Direction	Horiz. Distance	Height Difference
Beethers G.S.	0 00 00		above standpt	Job G.S.	0 00 00		above standpt
G.I. Pipe	01 01 01	2.857	above standpt 487	Trig plug	179 39 10.5	2.911	below standpt 435
Machway (P)	72 13 35		below	Beethers G.S.	216 41 06		below standpt
S.S.M.	142 59 08.5	2.913	above standpt 436	G.I. pipe	220 47 00.5	3.711	above standpt 050
Job G.S.	143 18 35		below	Machway (P)	288 54 03		below standpt
			above standpt				below
			below				below

Prepared by: [Signature] Checked: [Signature] Noted on U.T.M. Cart

St 2738-1

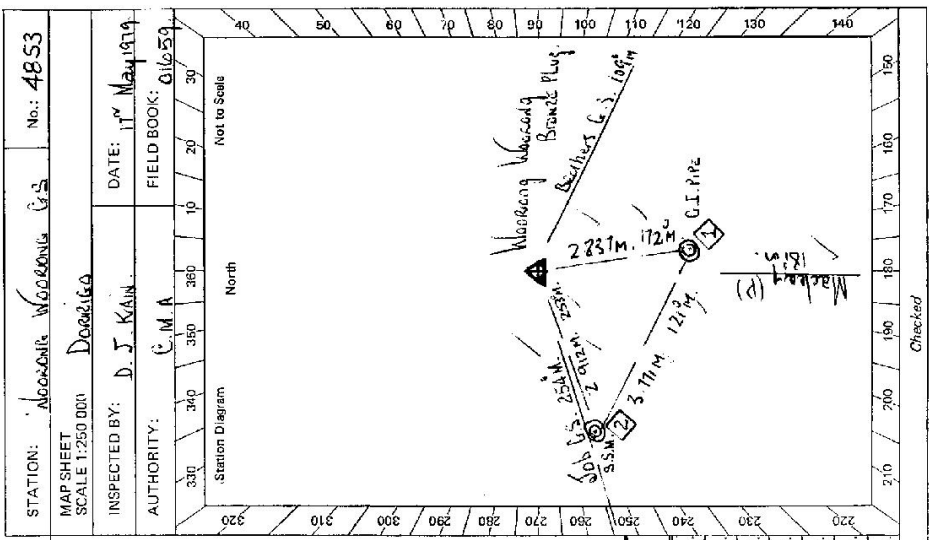

STATION: MCKENZIE WOODMONG G.S. No.: 4853
 MAP SHEET SCALE 1:250 000
 INSPECTED BY: D. J. KAIN DATE: 17 May 1979
 AUTHORITY: C.M.A. FIELD BOOK: 01659

STATION 1 NORONHA MOUNTAINS G.S. TS 4853

Owner's Name: KEE DEE SYMIE FOREST Current Occupant:

Address: Address:

Phone: Phone: 17-5-1979

ACCESS 17-5-1979

Access Report of 16/7/19 ~~was~~ found ~~unsuitable~~/unsuitable.

At Post Office Bellbrook at 0.0 Kilometres travel toward Kaitsey.

Kilometres

2.45 Turn Left into sealed Road, AT SIGN, to Nolla Nolla.

12.95 TAKE left fork in sealed Roads.

18.35 Pass house on your R.H.S.

18.50 Cross bridge over Nolla Creek.

18.70 Through slip rails on your L.H.S., follow trail access road.

18.95 Through slip rails on your R.H.S., follow trail up

20.15 Spur and then along ridge.

21.90 Through wire fence, follow trail and fence along ridge.

As far as possible by vehicle. Walk up ridge South westerly to trig.

Forty minutes fair walk with light load.

Date:

Records of Station:

