

CENTRAL MAPPING AUTHORITY

GEODETIC SURVEY OF M.S.M.
 GEODETIC STATION RECONNAISSANCE and MAINTENANCE REPORT

Description: *Note: Cross out word or words which do not apply*

- Cleared by James bearing.....*Note: Cross out word or words which do not apply*.....from Trig. Mast
- Mast & Vanes have been painted white & black respectively.
- The station/pillar was unpiled/not unpiled/constructed on.....19....., dimensions now being:
 Description of mark.....should be explicit, e.g., S/Steel Pillar Plate, Steel plug, Brass plug, Bolt, G.I. Pipe
 Height of mark.....m. ^{above} rock/concrete; Mark is.....m. ^{above} G.L.
 Height of Top Vanes to Top Mark/Pillar plate.....m. Diameter of Vanes (vertical).....m.
 Height of Cairn.....m. Diameter of Cairn.....m. Name Plate found/not found/placed.
 Length of Mast.....m. (approximate if not unpiled)
- A.....set in conc/rock has been placed/found, bearing.....° M from Mast/Plug/Pillar
- A.....set in conc/rock has been placed/found, bearing.....° M from Mast/Plug/Pillar
- A.....set in conc/rock has been placed/found, bearing.....° M from Mast/Plug/Pillar
- A.....set in conc/rock has been placed/found, bearing.....° M from Mast/Plug/Pillar

8. Action required:.....

STANDPOINT:

Mark	Direction	Horiz. Distance	Height Difference	Mark	Direction	Horiz. Distance	Height Difference
			above standpt				above standpt
			below				below
			above standpt				above standpt
			below				below
Prepared by: *[Signature]* 1.3.89
 Checked: *[Signature]* Noted on U.T.M. Card

SI 2733-1

STATION: WYNDHAM No.: 4869
 MAP SHEET: 1:250 000 WAGGA WAGGA
 SCALE: 1:250 000 WAGGA WAGGA
 INSPECTED BY: J. SUTTON DATE: 17 Feb 1989
 AUTHORITY: CMA FIELD BOOK: -

Station Diagram
 North
 Not to Scale

No surface mark or beacon found


STATION WYNDHAM TS 4869

Owner's Name: Terry Wright
 Address: 41 Dandenong 2644
 Via Bowing 2644
 Phone: (066) 203264

Current Occupant:
 Address:
 Phone:

ACCESS

Access Report of 17.2.1981 was found suitable/unsuitable.
 See Mullengandra 8326-35 1:25000 map

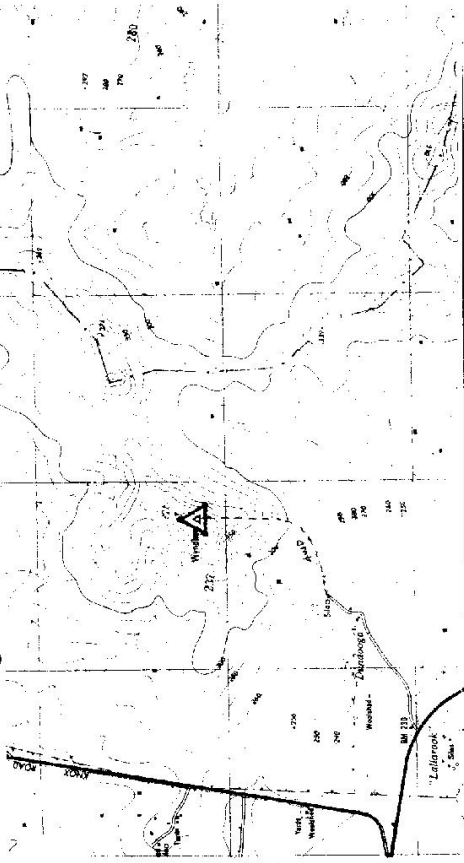


Date

Record of Station

6: 2753-2 D. Viel, Government Printer

Not to Scale

Beacon Diagram

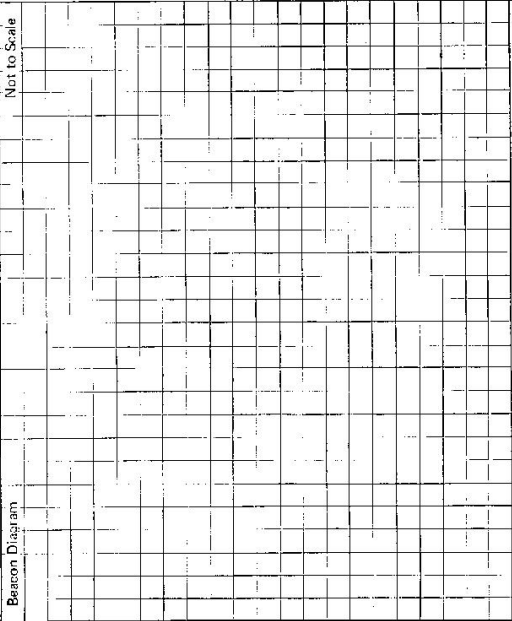

This section to be completed by officer constructing pillar.

Original station mark found/not found.

Description of mark:

Original beacon found/not found.

Description of beacon:

Height Top of Vanes to Top Mark.....m.

Height of mark.....m. above G.L. below

Diameter of Vanesm. Height of Cairnm.

Original Beacon has/has not been destroyed by me.