

GEODETTIC SURVEY OF NS/K

CENTRAL MAPPING AUTHORITY

GEODETTIC STATION RECONNAISSANCE and MAINTENANCE REPORT

Description:

Note: Cross out word or words which do not apply

1. Cleared by lanes bearing..... from Trig. Mast
2. Mast & Vanes have been painted white & black respectively.
3. The station/pillar was unpiled/not unpiled/constructed on.....19....., dimensions now being:
G.I. Mark
 Description of mark.....should be explicit, e.g, S/Steel Pillar Plate, Steel plug, Brass plug, Bolt, G.I. Pipe
 Height of mark.....m. ^{above} _{below} rock/concrete; Mark is.....m. ^{above} _{below} G.L.
- Height of Top Vanes to Top Mark/Pillar platem. Diameter of Vanes (vertical).....m.
- Height of Cairn.....m. Diameter of Cairn.....m. Name Plate found/not found/placed.
- Length of Mast.....m. (approximate if not unpiled)
4. A.....set in conc/rock has been placed/found, bearing.....°M from Mast/Plug/Pillar
5. A.....set in conc/rock has been placed/found, bearing.....°M from Mast/Plug/Pillar
6. A.....set in conc/rock has been placed/found, bearing.....°M from Mast/Plug/Pillar
7. A.....set in conc/rock has been placed/found, bearing.....°M from Mast/Plug/Pillar
8. Action required: *Remove. See Appendix. Site considered by light timber. Drive to Trig. if necessary.*

STANDPOINT:

Mark	Direction	Horiz. Distance	Height Difference	Mark	Direction	Horiz. Distance	Height Difference
			above standpt				above standpt
			below standpt				below standpt
			above standpt				above standpt
			below standpt				below standpt
Checked:

Noted on U.T.M. Card

Prepared by: *Rohay Soek*


ST 2758-1

STATION: S.M.A. 769 No.: 487

MAP SHEET SCALE 1:250 000 TANTANGARA 1:100,000

INSPECTED BY: R. COOK DATE: 10-3-79

AUTHORITY: C.M.A. FIELD BOOK:

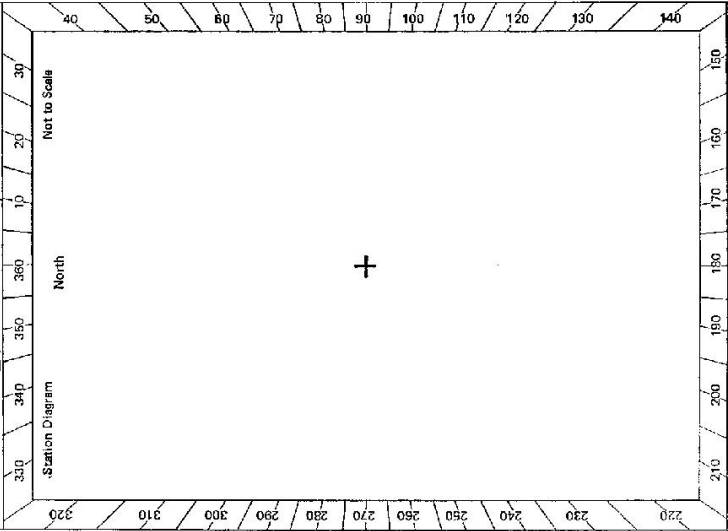


Checked

Sr 2733-2 D. Watt, Government Printer

GS 24

STATION **S.M.A. 769 IS 487**

Owner's Name:
 Address: Situated within the
Kosciuszko National Park
 Phone:
 ACCESS
 Access Report of 10/3/1977 was found suitable/unsuitable.
 Current Occupant:
 Address:
 Phone: SAMA 769

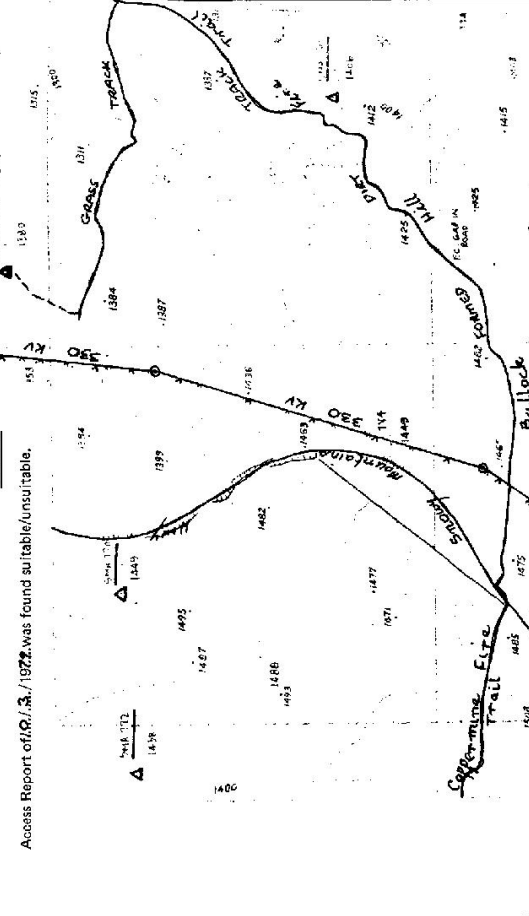

Beacon Diagram	Not to Scale

This section to be completed by officer constructing pillar.

Original station mark found/not found.
 Description of mark:
 Original beacon found/not found.
 Description of beacon:
 Height Top of Vane to Top Mark:m.
 Height of mark:m. above G.L.
 below G.L.
 Diameter of Vane:m. Height of Cairn:m.
 Original Beacon has/had not been destroyed by me.

Date: 10-3-77
 Record of Station
Recognition of Trig during field completion of Tanthanganga 1:25,000.
Access taken off the Tanthanganga 1:25,000 (revision 1)