

CENTRAL MAPPING AUTHORITY

GEODETIC SURVEY OF N.S.W.

GEODETIC STATION RECONNAISSANCE and MAINTENANCE REPORT

Description:

Note: Cross out word or words which do not apply

1. Cleared by lanes bearing: **Timbered 300** - **3 days cleaning** from Trig. Mast
2. **Mast & Vanes have been painted white & black respectively. Beacon in good condition - needs painting**
3. The station/pillar was unpiled/not unpiled/constructed on 19 dimensions now being:

Description of mark..... should be explicit, e.g., S/Steel Pillar Plate, Steel plug, Brass plug, Bolt, G.I. Pipe

Height of mark..... m. ^{above}/_{below} rock/concrete; Mark is..... m. ^{above}/_{below} G.L.

Height of Top Vanes to Top Mark/Pillar plate m. Diameter of Vanes (vertical)..... m.

Height of Cairn..... m. Diameter of Cairn..... m. Name Plate found/not found/placed.

Length of Mast..... m. (approximate if not unpiled)

4. A..... **S.S.M.** set in conc/rock has been ~~placed~~/found, bearing **70°** M from Mast/~~Plug/Pillar~~ at **2.6 m**
5. A..... **G.I. Pipe** set in conc/rock has been ~~placed~~/found, bearing **278°** M from Mast/~~Plug/Pillar~~ at **2.5 m**
6. A..... set in conc/rock has been placed/found, bearing.....° M from Mast/Plug/Pillar
7. A..... set in conc/rock has been placed/found, bearing.....° M from Mast/Plug/Pillar

8. Action required.....

STANDPOINT:

STANDPOINT:

Mark	Direction	Horiz. Distance	Height Difference	Mark	Direction	Horiz. Distance	Height Difference
			above standpt.				above standpt.
			below				below
			above standpt.				above standpt.
			below				below
Prepared by: *A. S. [Signature]*

8-8-80

Checked: *[Signature]*

Noted on U.T.M. Card


S: 2733-1

STATION: **WYNDHAM** No.: **4871**

MAP SHEET SCALE 1:250 000 **Warwick**

INSPECTED BY: **A. S. Inertsen** DATE: **2-8-80**

AUTHORITY: **CMA** FIELD BOOK: **1848**

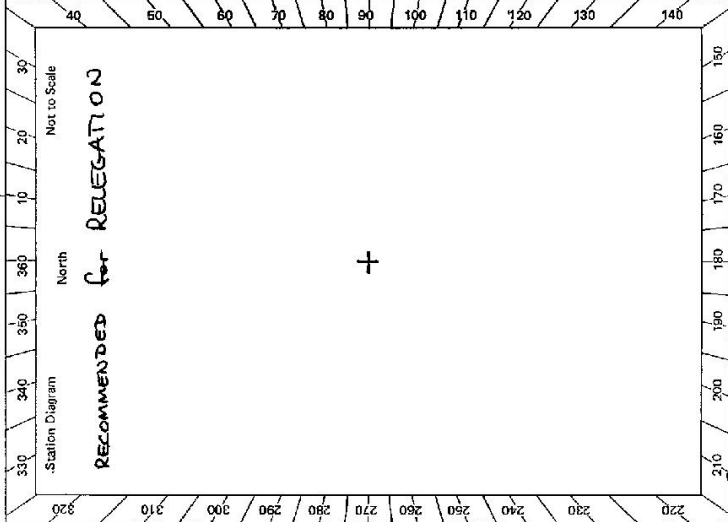

S. [Signature] 10/1/80 Checked

