

CENTRAL MAPPING AUTHORITY

GEODETIC SURVEY OF M.S.W.

GEODETIC STATION RECONNAISSANCE and MAINTENANCE REPORT

STATION: **YADDRA** No.: **4882**

Description: *Note: Cross out word or words which do not apply*

MAP SHEET SCALE 1:250 000 **CARGELLIGO**

1. Cleared by lanes bearing..... from Trig. Mast

INSPECTED BY: **Gr. C. HANNA** DATE: **25/5/79**

2. Mast & Vanes have been painted white & black respectively.

AUTHORITY: **C. M. A.** FIELD BOOK:

3. The station/pillar was unpiled/not unpiled/constructed on..... 19..... dimensions now being:

Station Diagram

Description of mark..... should be explicit, e.g., S/Steel Pillar Plate, Steel plug, Brass plug, Bolt, G.I. Pipe

North

Height of mark.....m. above rock/concrete; Mark is.....m. above G.L.

North

Height of Top Vanes to Top Mark/Pillar plate.....m. Diameter of Vanes (vertical).....m.

North

Height of Cairn.....m. Diameter of Cairn.....m. Name Plate found/not found/placed.

North

Length of Mast.....m. (approximate if not unpiled)

North

4. A.....set in conc/rock has been placed/found, bearing.....° M from Mast/Plug/Pillar

North

5. A.....set in conc/rock has been placed/found, bearing.....° M from Mast/Plug/Pillar

North

6. A.....set in conc/rock has been placed/found, bearing.....° M from Mast/Plug/Pillar

North

7. A.....set in conc/rock has been placed/found, bearing.....° M from Mast/Plug/Pillar

North

8. Action required:.....

North

STANDPOINT:

North

Mark	Direction	Horiz. Distance	Height Difference	Mark	Direction	Horiz. Distance	Height Difference
			above standpt.				above standpt.
			below standpt.				below standpt.
			above standpt.				above standpt.
			below standpt.				below standpt.
Net to Scale

Prepared by: *Griffiths* 25/5/79

Checked

Checked

Noted on U.T.M. Card

Checked

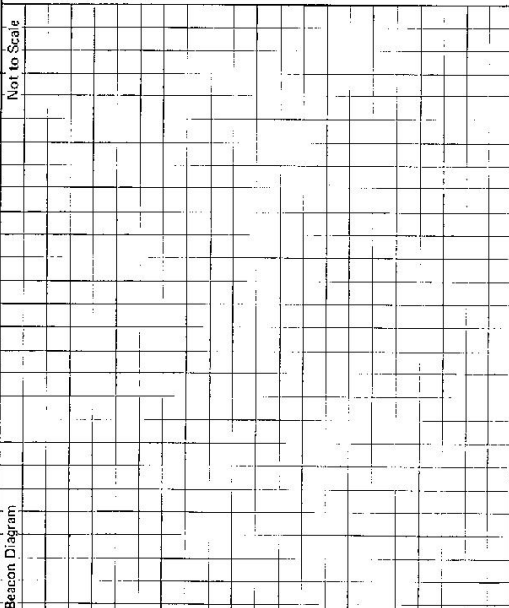
Checked

Checked

Sr-2753--2 D. West, Government Printer Beacon Diagram	STATION YADDRA TS 4-882
Not to Scale 	Owner's Name: Address: Phone: Current Occupant: Address: Phone: ACCESS Access Report of 27/5/1977 was found suitable/unsuitable. Destroyed vanes found. No sign of cairn or mast. Drive to. No clearing. See Kiacootoo 8231 - N
	This section to be completed by officer constructing pillar. Original station mark found/not found. Description of mark: Original beacon found/not found. Description of beacon: Height Top of Vanes to Top Mark:m. Height of mark:m. above below Diameter of Vanes:m. Height of Cairn:m. Original Beacon has/has not been destroyed by me.
Date Record of Station	
.....	