

CENTRAL MAPPING AUTHORITY

GEODETIC SURVEY OF NSW

GEODETIC STATION RECONNAISSANCE and MAINTENANCE REPORT

STATION: SMA 771 No: 489

MAPSHEET SCALE 1:250 000 CANTBERRA

INSPECTED BY: K. HADDOUD DATE: March 1974


AUTHORITY: CMA FIELD BOOK:

Description:
 1. Cleared by lanes bearing..... Note: Cross out word or words which do not apply
 2. Mast & Vanes have been painted white & black respectively. from Trig. Mast
 3. The station/pillar was unpiled/not unpiled/constructed on..... 19....., dimensions now being:
 Description of mark..... should be explicit, e.g., S/Steel Pillar Plate, Steel plug, Brass plug, Bolt, G.I. Pipe
 Height of mark..... m. ^{above} ~~below~~ rock/concrete; Mark is..... m. ^{above} ~~below~~ G.L.
 Height of Top Vanes to Top Mark/Pillar plate m. Diameter of Vanes (vertical)..... m.
 Height of Cairn..... m. Diameter of Cairn..... m. Name Plate found/not found/placed.
 Length of Mast..... m. (approximate if not unpiled).
 A. A..... set in conc/rock has been placed/found, bearing..... ° M from Mast/Plug/Pillar
 A. A..... set in conc/rock has been placed/found, bearing..... ° M from Mast/Plug/Pillar
 A. A..... set in conc/rock has been placed/found, bearing..... ° M from Mast/Plug/Pillar
 A. A..... set in conc/rock has been placed/found, bearing..... ° M from Mast/Plug/Pillar
 8. Action required:.....

STANDPOINT:

Mark	Direction	Horiz. Distance	Height Difference	Mark	Direction	Horiz. Distance	Height Difference
			above standpt.				above standpt.
			below				below
			above standpt.				above standpt.
			below				below
Prepared by: K. Haddoud Checked: Noted on U.T.M. Card

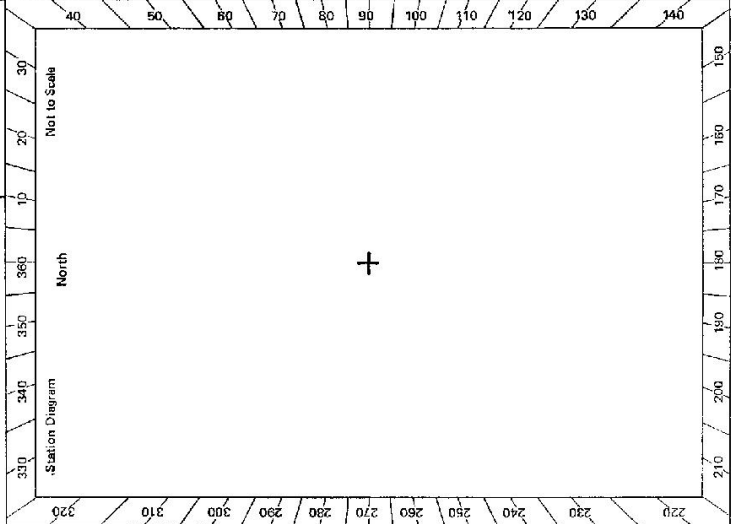

(18)

STATION SMA 771 IS 489	
Date March 1979	Record of Station Visited completely surrounded by large tree. Not recommended as geodetic station.

<p>Beacon Diagram</p> <p style="text-align: right;">Not to Scale</p>	<p>This section to be completed by officer constructing pillar.</p> <p>Original station mark found/not found.</p> <p>Description of mark:</p> <p>Original beacon found/not found.</p> <p>Description of beacon:</p> <p>Height Top of Vanes to Top Markm. above G.L. below</p> <p>Height of markm. below</p> <p>Diameter of Vanesm. Height of Cairnm.</p> <p>Original Beacon has/has not been destroyed by me.</p>
--	--