

GEODETIC SURVEY OF N.S.W.

CENTRAL MAPPING AUTHORITY

GEODETIC STATION RECONNAISSANCE and MAINTENANCE REPORT

Description:

1. Cleared by lances bearing $54^{\circ} 14' M$, $146^{\circ} 13' M$, $198^{\circ} M$ from S.S.M. ~~from Trig. Mast~~
Note: Cross out word or words which do not apply
2. Mast & Vane have been painted white & black respectively.
 Trig. Plug
3. The station/pillar was unpiled/~~not unpiled~~/~~constructed~~ on March 1977, dimensions now being: 19.7 x 19.7 m.
 Bottle should be explicit, e.g. S/Steel Pillar Plate, Steel plug, Brass plug, Bolt, G.I. Pipe
- Description of mark: Bottle
- Height of mark: 0.00 m. ^{above} ~~below~~ rock/concrete; Mark is 0.00 m. ^{above} ~~below~~ G.L.
- Height of Top Vanes to Top Mark: ~~1.14~~ m. See below. Diameter of Vanes (vertical) 0.00 m.
- Height of Cairn: 0.00 m. Diameter of Cairn 0.00 m. ~~Name Plate found/not found/placed.~~
- Length of Mast: 0.00 m. (approximate if not unpiled)
4. A. S.S.M. set in ~~conc/rock~~ rock has been placed/~~found~~, bearing 125^{\circ} 00' M from ~~Mast/Plug/Pillar~~
5. A. S.S.M. set in conc/rock has been placed/~~found~~, bearing 107^{\circ} 09' 06'' M from Mast/Plug/Pillar
6. A. S.S.M. set in conc/rock has been placed/~~found~~, bearing 218^{\circ} 10' 55'' M from Mast/Plug/Pillar
7. A. S.S.M. set in conc/rock has been placed/~~found~~, bearing 0^{\circ} 00' 00'' M from Mast/Plug/Pillar
8. Action required: New Mast required (rotten). Vane OK.

STANDPOINT: Trig. Plug

STANDPOINT: SSM

Mark	Direction	Horiz. Distance	Height Difference	Mark	Direction	Horiz. Distance	Height Difference
PM 45965 BTI	$0^{\circ} 00' 00''$		above standpt.	G.S. Fletcher CB1	$0^{\circ} 00' 00''$		above standpt.
SSM	$285^{\circ} 53' 33''$	15.907	below	G.S. Yarrarford	$107^{\circ} 09' 06''$		below standpt.
			below	G.S. Hinkler CB1	$218^{\circ} 10' 55''$		below standpt.
			below				below standpt.
			below				below standpt.
Prepared by: R. PAITON (D.M.R.)

Checked: *[Signature]*

Noted on U.T.M. Card

SC 2733-1

STATION: G.S. YARRAFORD TS No.: 4902
 MAP SHEET SCALE 1:250 000 GRAFTON
 INSPECTED BY: G. GUNSBERGER DATE: March 77
 AUTHORITY: D. M. R. FIELD BOOK: C. 168

Station Diagram

North

Not to Scale

Checked

81 2735-2 D. West, Government Printer Beacon Diagram Not to Scale	<p style="text-align: center; font-weight: bold; font-size: 1.2em;">YARRAFORD G.S. 4902</p> <p>STATION</p> <p>Owner's Name: John FORWARDS Address: MIERLYN YARRAFORD Phone:</p> <p>Current Occupant: Owner Address:</p> <p>Phone:</p> <p style="text-align: center; font-weight: bold;">ACCESS</p> <p>Access Report of 23/10/77 was found suitable/unsuitable. No previous access details</p>	
<p style="text-align: center; font-weight: bold; font-size: 1.5em;">NOT ERECTED</p> <p style="text-align: center;">in very poor condition</p>	<p>This section to be completed by officer constructing pillar.</p> <p>Original station mark found/not found.</p> <p>Description of mark:</p> <p>Original beacon found/not found.</p> <p>Description of beacon:</p> <p>Height Top of Vane to Top Mark: m</p> <p>Height of mark: m. above rock/cconc. below G.L.</p> <p>Diameter of Vane: m. Height of Cairn: m.</p> <p>Original Beacon has/has not been destroyed by me.</p>	
<p>Date</p> <p>Record of Station</p>		<p>to Tenterfield</p>

GEODETTIC SURVEY OF N.S.W.

CENTRAL MAPPING AUTHORITY


GEODETTIC STATION RECONNAISSANCE and MAINTENANCE REPORT

STATION: **YARRAFFORD** No.: **TS 4902**

MAP SHEET SCALE 1:250 000 **BRADFORD**

INSPECTED BY: **J. FARMING** DATE: **2/8/78**

AUTHORITY: **C.M.A.** FIELD BOOK:

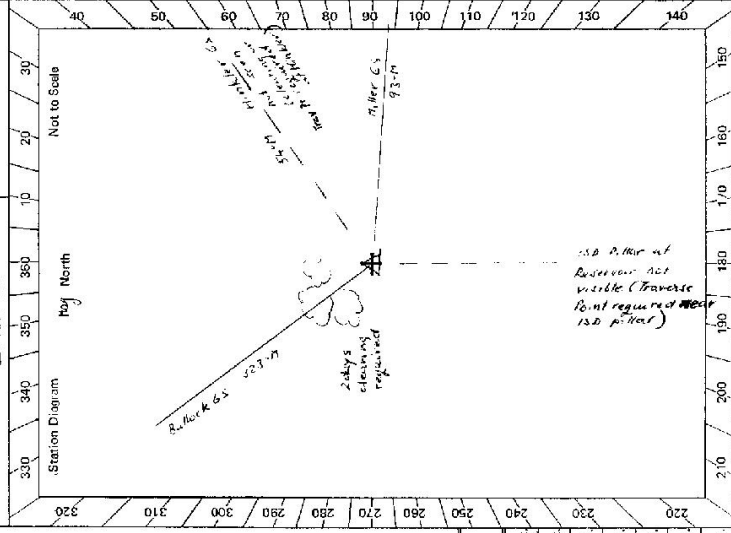

- Description:
- Note: Cross out word or words which do not apply
- Cleared by Janes bearing..... from Trig. Mast
 - Mast & Vanes have been painted white & black respectively.
 - The station/~~pillar~~ was unpiled/~~not re-constructed~~ on..... **2nd. Aug. 19. 27.1.**, dimensions now being: **hole in ground 4d. but searched for mark**
Description of mark..... should be explicit, e.g., S/Steel Pillar Plate, Steel plug, Brass plug, Bolt, G.I. Pipe
Height of mark..... m. ^{above} _{below} rock/concrete; Mark is..... m. ^{above} _{below} G.L.
 - Height of Top Vanes to Top Mark/Pillar plate..... m. Diameter of Vanes (vertical)..... m.
 - Height of Cairn..... m. Diameter of Cairn..... m. Name Plate found/not found/placed.
 - Length of Mast..... m. (approximate if not unpiled)
 - A..... set in conc/rock has been placed/found, bearing..... M from Mast/Plug/Pillar **No marks found**
 - A..... set in conc/rock has been placed/found, bearing..... M from Mast/Plug/Pillar
 - A..... set in conc/rock has been placed/found, bearing..... M from Mast/Plug/Pillar
 - A..... set in conc/rock has been placed/found, bearing..... M from Mast/Plug/Pillar
 - Action required: **2 days clearing. new pillar. 1 set. mark.**

STANDPOINT:

Mark	Direction	Horiz. Distance	Height Difference	Mark	Direction	Horiz. Distance	Height Difference
			above standpt. below				above standpt. below
			above standpt. below				above standpt. below
Prepared by: **J. Farming** Checked: **W. Johnson 7/1/78** Noted on U.T.M. Card

