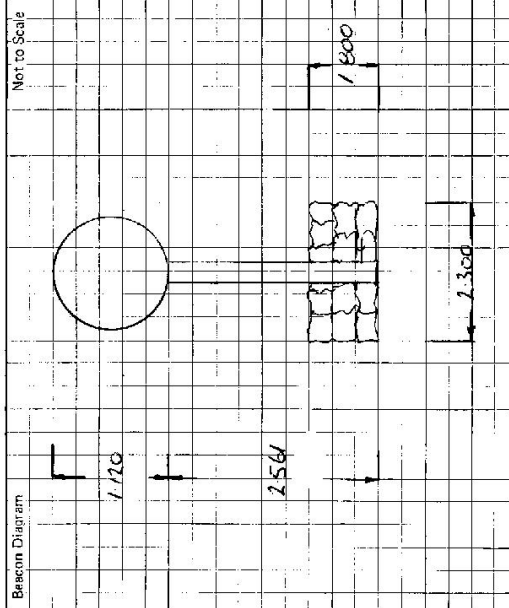


STATION YANRARI G.S.	TS 4912	Owner's Name: MR. J. LEFFERIES Address: GAANVEDAH Phone: Current Occupant: HARSH MANSINGH Address: Phone: ACCESS 19-12-1980
Access Report of 28/9/1980 was found suitable/unsuitable. P.O. GOVINDAH HEAD WEST ALONG COMMUNITY ST. 0 45 TURN RIGHT INTO CHAROOS ST 1 1 CROSS BRIDGE 4 55 PASS ROAD TO KEEPIT DAM ON RIGHT 20 95 CROSS CAUSEWAY BETWEEN CHURCH + HALL. * 21 55 TURN RIGHT AT SMALL GREEN LETTERBOX 22 6 THROUGH TWO IRON GATES 23 55 CROSS GULLY THROUGH GAP IN FENCE 23 85 THROUGH IRON GATE + TAKE TRACK TO RIGHT CARETAKERS HOUSE ON LEFT. 24 05 THROUGH GAP IN FENCE 24 1 TURN LEFT BEFORE GATE 25 05 TRACK VEERS LEFT AWAY FROM FENCE. DAM ON LEFT. 25 6 TURN LEFT OFF MAIN TRACK FOLLOW WINDZEL MARKS UP HILL THEN MAKE OWN WAY UP TO G.S. 26 65 YANRARI G.S. * AT 22 55 CONTINUE ALONG BITUMEN TO 28 3 THEN TURN RIGHT CONTINUE to 29 00 OWNERS HOUSE IS ON RIGHT.		Date Record of Station
Beacon Diagram 1/120 2564 	This section to be completed by officer constructing pillar. Original station mark found/ not found . Description of mark: BRASS PILL IN CONCRETE Original beacon found/ not found . Description of beacon: CANN PILE DIS Height Top of Vanes to Top Mark: 4.290 m. Height of mark 4.290 m. <small>above below</small> rock/conc. <small>above below</small> G.L. Diameter of Vanes 1.110 m. Height of Cairn 0.950 m. Original Beacon has has not been destroyed by me.	