

CENTRAL MAPPING AUTHORITY

GEODETIC SURVEY OF M.S.W.

GEODETIC STATION RECONNAISSANCE and MAINTENANCE REPORT

Description:

1. Cleared by lanes bearing $18^\circ 92' 110-120 / 153 / 205 - 330$ from Trig. Mast
Note: Cross out word or words which do not apply
2. Mast & Vanes have been painted white & black respectively. ✓
3. The station/pillar was ~~unpiled~~/not unpiled/constructed on19....., dimensions now being: Description of mark.....should be explicit, e.g., S/Steel Pillar Plate, Steel plug, Brass plug, Bolt, G.I. Pipe
Height of mark.....m, above rock/concrete; Mark is.....m, above G.L.
Height of Top Vanes to Top ~~Mark~~/Cairn/plate2.10.....m. Diameter of Vanes (vertical).....1.01.....m.
Height of Cairn.....1.5.....m. Diameter of Cairn.....2.0.....m. Name Plate found/not found/placed.
Length of Mast.....m. (approximate if not unpiled)
4. A. S/S ~~Pillar~~ Trig. set in conc/rock has been placed/found, bearing 188° M from Mast/Pillar of 4.45 m
5. A.....set in conc/rock has been placed/found, bearing.....° M from Mast/Pillar
6. A.....set in conc/rock has been placed/found, bearing.....° M from Mast/Pillar
7. A.....set in conc/rock has been placed/found, bearing.....° M from Mast/Pillar
8. Action required:.....

KANGAROO VALLEY
St. Topo

STANDPOINT:

Mark	Direction	Horiz. Distance	Height Difference	Mark	Direction	Horiz. Distance	Height Difference
			above below				above below
			standpt.				standpt.
			above below				above below
			standpt.				standpt.
Prepared by: *[Signature]* Checked: *[Signature]*

Noted on U.T.M. Card

St 2733-1

STATION: **YARRAWA** No.: **4914**

MAP SHEET SCALE 1:250 000 **Wollongong**

INSPECTED BY: **A. Sivertsen** DATE: **16-1-79**

AUTHORITY: **CMA** FIELD BOOK: **1723**

Station Diagram

North


Banangory (Hill) 22.85m

Good Δ site if control needed here

+

Not to Scale

STATION	YARRAWA	TS 4914
Owner's Name: <u>CROWN LAND</u>	Current Occupant:	
Address:	Address:	
Phone:	Phone:	
<u>ACCESS</u>		
Access Report of <u>h.l./19.71</u> was found suitable/unavailable.		
0.0 km <u>ROBERTSON P.O. towards WOLLONGONG</u>		
0.3 <u>Turn R towards BELMORE FALLS & follow signs turning R at 0.55 and L at 0.8</u>		
5.3 <u>Take R fork towards falls</u>		
7.5 <u>Take WALLABY HILL RD to left. (Abt 15km to falls)</u>		
	<u>La continue along main track</u>	
8.6 <u>Take R fork through old gate</u>		
8.8 <u>Pass house on R</u>		
9.3 <u>Pass track on L</u>		
10.3 <u>Pass track on L</u>		
11.3 <u>Take wheel track to R</u>		
11.4 <u>Take R fork</u>		
11.5 <u>△ YARRAWA</u>		

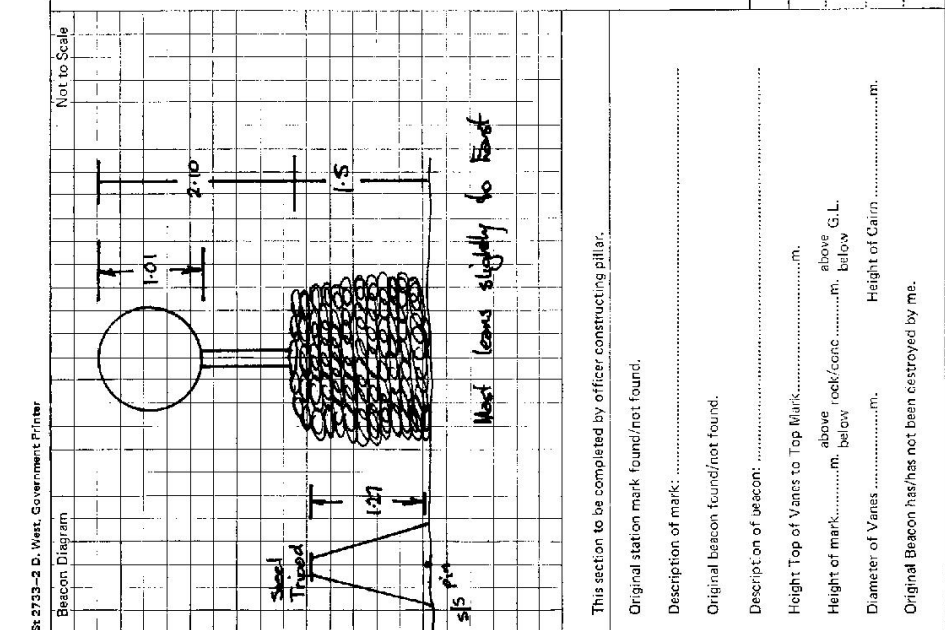

Date	Number of Station