

GEODETTIC SURVEY OF N.S.W.

CENTRAL MAPPING AUTHORITY

GEODETTIC STATION RECONNAISSANCE and MAINTENANCE REPORT

Description:

Note: Cross out word or words which do not apply

1. Cleared by lanes bearing..... from Trig, Mast
only
2. Mast & Vanes have been painted white & black respectively in lanes of roots found
3. The station/pillar was unpiled/not unpiled/constructed on..... 19....., dimensions now being:
Description of mark..... should be explicit; e.g., S/Steel Pillar Plate, Steel plug, Brass plug, Bolt, G.I. Pipe
Height of mark.....m. above rock/concrete; Mark is.....m. above G.L.
Height of Top Vanes to Top Mark/Pillar plate.....m. Diameter of Vanes (vertical).....m.
Height of Cairn.....m. Diameter of Cairn.....m. Name Plate found/not found/placed.
Length of Mast.....m. (approximate if not unpiled)
4. A..... set in conc/rock has been placed/found, bearing.....°M from Mast/Plug/Pillar
5. A..... set in conc/rock has been placed/found, bearing.....°M from Mast/Plug/Pillar
6. A..... set in conc/rock has been placed/found, bearing.....°M from Mast/Plug/Pillar
7. A..... set in conc/rock has been placed/found, bearing.....°M from Mast/Plug/Pillar
8. Action required: Station drive-to. Suitable for pillar construction.
No clearing required

STANDPOINT:

STANDPOINT:

Mark	Direction	Horiz. Distance	Height Difference	Mark	Direction	Horiz. Distance	Height Difference
			above standpt.				above standpt.
			below standpt.				below standpt.
			above standpt.				above standpt.
			below standpt.				below standpt.
			above standpt.				above standpt.
			below standpt.				below standpt.
			above standpt.				above standpt.
			below standpt.				below standpt.

Prepared by: *Adams*

Checked:

Noted on U.T.M. Card


Checked

STATION: *Yeumburra* No.: *4936*


MAP SHEET
SCALE 1:250 000
Canberra

INSPECTED BY: *P.K. Bamob.* DATE: *May 78*

AUTHORITY: *C.M.A.* FIELD BOOK:

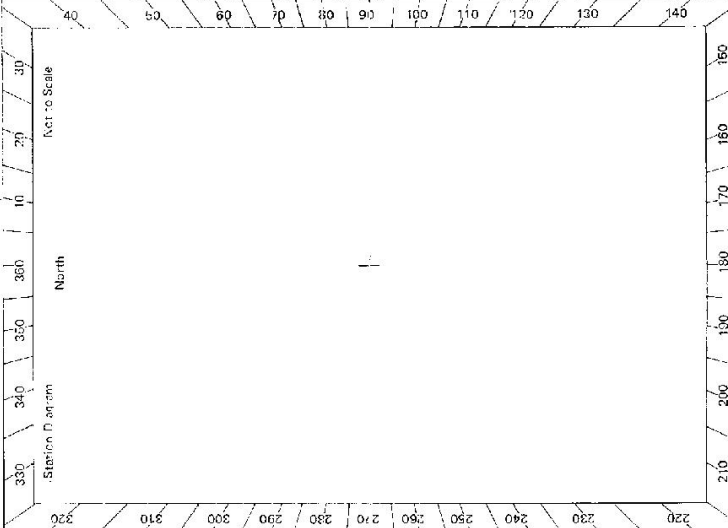

GS 24

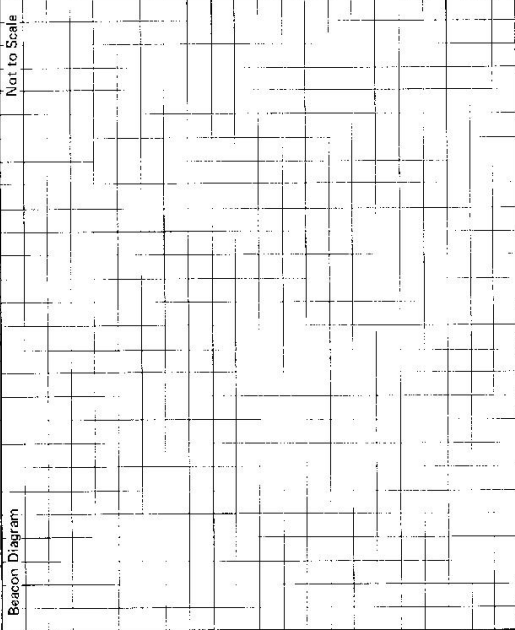STATION Yaumburra T's 4936	<table style="width: 100%; border-collapse: collapse;"> <tr> <td style="width: 30%; border-bottom: 1px solid black;"> Owner's Name: Address: Phone: </td> <td style="width: 30%; border-bottom: 1px solid black;"> Current Occupant: Address: Phone: </td> <td style="width: 40%; border-bottom: 1px solid black;"> ACCESS Access Report of/19..... was found suitable/unsuitable. <i>A. A wheel drive vehicle can be driven right up to the station. Refer Toamas Bridge 8627-1-N</i> </td> </tr> </table>	Owner's Name: Address: Phone:	Current Occupant: Address: Phone:	ACCESS Access Report of/19..... was found suitable/unsuitable. <i>A. A wheel drive vehicle can be driven right up to the station. Refer Toamas Bridge 8627-1-N</i>					
Owner's Name: Address: Phone:	Current Occupant: Address: Phone:	ACCESS Access Report of/19..... was found suitable/unsuitable. <i>A. A wheel drive vehicle can be driven right up to the station. Refer Toamas Bridge 8627-1-N</i>							
Beacon Diagram 	<p>This section to be completed by officer constructing pillar.</p> <p>Original station mark found/not found.</p> <p>Description of mark:</p> <p>Original beacon found/not found.</p> <p>Description of beacon:</p> <p>Height Top of Vases to Top Mark.....m. above below Height of mark.....m. rock/conc.....m. Height of Cairn.....m. above below</p> <p>Diameter of Vases.....m.</p> <p>Original Beacon has/has not been destroyed by me.</p>								
	<table style="width: 100%; border-collapse: collapse;"> <thead> <tr> <th style="width: 10%; border-bottom: 1px solid black;">Date</th> <th style="width: 90%; border-bottom: 1px solid black;">Record of Station</th> </tr> </thead> <tbody> <tr> <td style="border-bottom: 1px solid black;"> </td> <td style="border-bottom: 1px solid black;"> </td> </tr> <tr> <td style="border-bottom: 1px solid black;"> </td> <td style="border-bottom: 1px solid black;"> </td> </tr> <tr> <td style="border-bottom: 1px solid black;"> </td> <td style="border-bottom: 1px solid black;"> </td> </tr> </tbody> </table>	Date	Record of Station						
Date	Record of Station								