

CENTRAL MAPPING AUTHORITY

GEODETIC SURVEY OF N.S.W.

GEODETIC STATION RECONNAISSANCE and MAINTENANCE REPORT

Description:

Note: Cross out word or words which do not apply

1. Cleared by lanes bearing..... STATION SURROUNDED BY 5 MINS TO MED. TREES. from Trig. Mast
2. Mast & Vanes have been painted white & black respectively.
3. The station/~~pillar~~ was ~~supplied~~/not unplied/~~constructed~~ on..... 14-8-1981, dimensions now being:
Description of mark..... should be explicit, e.g., S/Steel Pillar Plate, Steel plug, Brass plug, Bolt, G.I. Pipe
Height of mark..... m. ^{above} rock/concrete; SMALL PILE OF STONES FOUND
Mark is..... m. ^{above} G.L.
4. A..... set in conc/rock has been placed/found, bearing..... ° M from Mast/Plug/Pillar
5. A..... set in conc/rock has been placed/found, bearing..... ° M from Mast/Plug/Pillar
6. A..... set in conc/rock has been placed/found, bearing..... ° M from Mast/Plug/Pillar
7. A..... set in conc/rock has been placed/found, bearing..... ° M from Mast/Plug/Pillar
8. Action required:..... STATION OF LITTLE VALUE TOO CLOSE TO COPPERMUNNA.....


STANDPOINT:

Mark	Direction	Horiz. Distance	Height Difference	Mark	Direction	Horiz. Distance	Height Difference
			above standpt.				above standpt.
			below				below
			above standpt.				above standpt.
			below				below
Prepared by: Adrian 15/10/81 Checked:

St 2733-1

Noted on U.T.M. Card

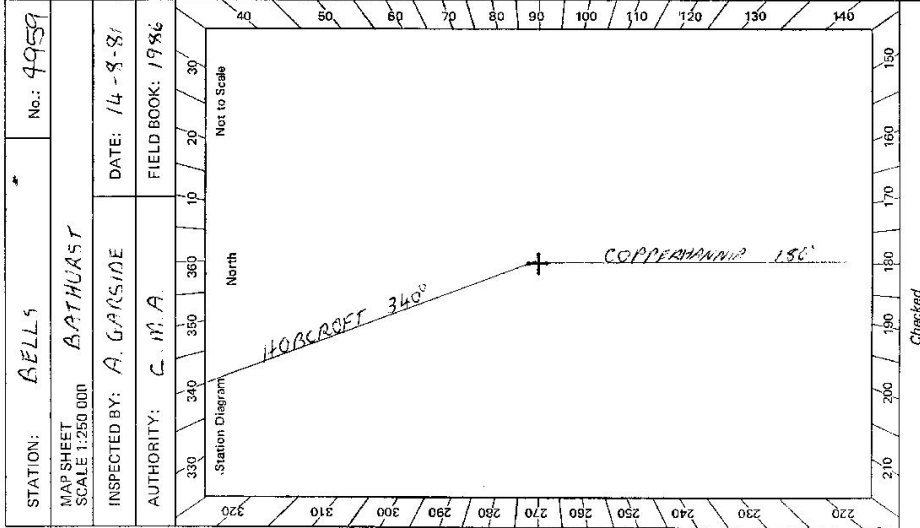

Checked

CENTRAL MAPPING AUTHORITY
Department of Lands

Trigonometrical Survey of N.S.W.

RECONNAISSANCE and MAINTENANCE REPORT

7-4-08

STATION BELLS

4959

Co: CARRINGTON PH: COPPERMUNDA

Map Sheet: A88RCR08B1C No: 8730 IIa/II

Inspected by: Date:

Authority: Field Book:

Beacon Diagram: Net to Scale

Note: Cross out word or words which do not apply

This Trig. Station has been:-

1. Completely cleared to permit 360° vision to surrounding Trigs.
2. Cleared by lanes bearing from Trig. Mast
3. Trig. Mast & Vanes have been painted white & black respectively.
4. The Trig. was unpiled/not unpiled, dimensions now being: Original Station Mast found: not found

Description of mark should be explicit, e.g. Steel plug, Brass plug, Bolt, G.I. Pipe
 Height of mark m above rock/concrete m below G.L.
 Height of Top Vanes to Top Mark m. Diameter of Vanes (vertical) m.
 Height of Cairn m. Diameter of Cairn m.

5. A m. (approximate if not unpiled)
6. A set in conc/rock has been placed m. bearing °M from Trig. Mast
7. A set in conc/soil has been placed m. bearing °M from Trig. Mast
8. A set in conc/soil has been placed m. bearing °M from Trig. Mast
9. A set in conc/rock has been placed m. bearing °M from Trig. Mast

10. Connection to m. bearing °M
11. Connection to m. bearing °M
12. Connection to m. bearing °M
13. Diff. Ht. is m. above below
14. Diff. Ht. is m. above below
15. Diff. Ht. is m. above below
16. Diff. Ht. is m. above below

ACCESS ONLY

Date	Record of Station

Noted on U.T.M. Card

Checked:

Prepared by:

Checked

65191


STATION BELLS

Owners Name.....
 Address.....
 Access.....
 Current Occupant.....
 Address.....
 Address.....

Not to Scale

Station Diagram


North

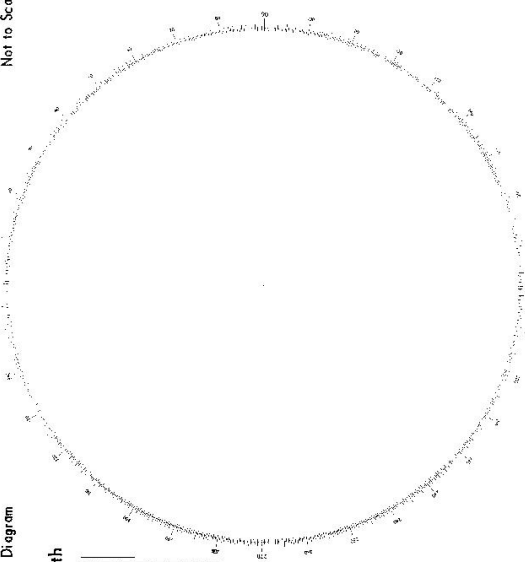

List of Observed Directions :-

Standpoint:

Station	Direction	Station	Direction

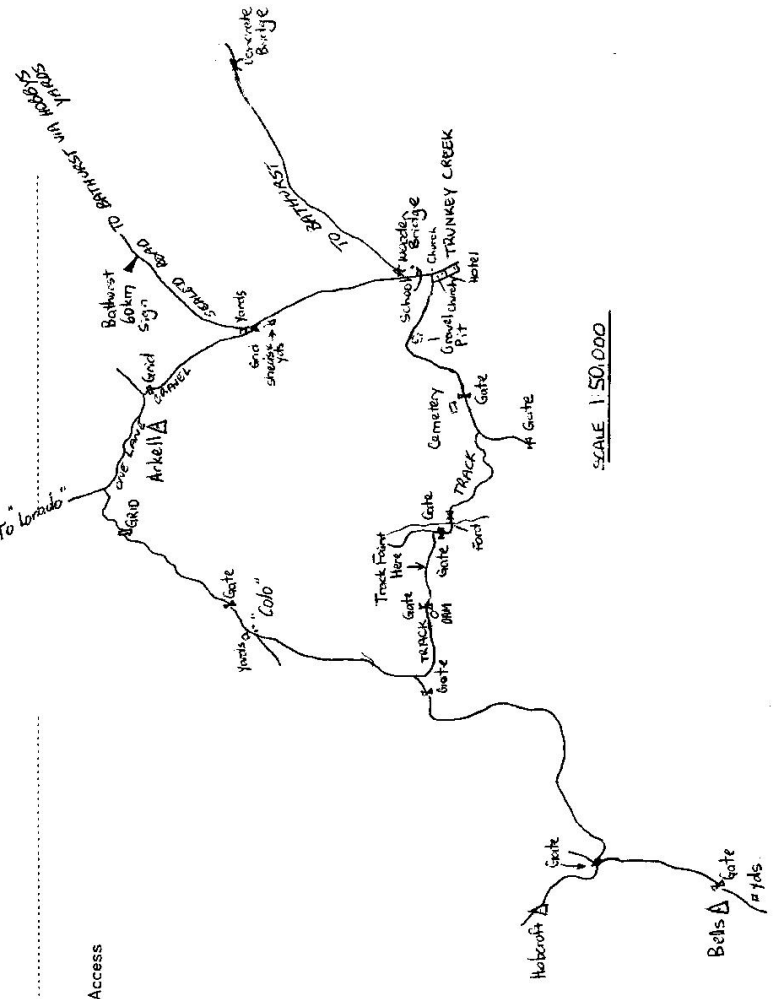

SCALE 1:50,000

7498

Trigonometrical Survey of N.S.W.

RECONNAISSANCE and MAINTENANCE REPORT

CENTRAL MAPPING AUTHORITY
Department of Lands

STATION **BELLS** * **4959**

Co: **GREENLANDIA** Ph: **CORPSEMANIA**

Map Sheet: **BATHURST 1 250 000** No:

Inspected by: **K. H. O'BRIEN** Date: **18.5.78**

Authority: **C.M.A.** Field Book:

Beacon Diagram: **Not to Scale**

This Trig. Station has been:-

Note: Cross out word or words which do not apply

1. Completely cleared to permit 360° vision to surrounding Trigs.
2. Cleared by lanes bearing..... from Trig. Mast
3. Trig. Mast & Vanes have been painted white & black respectively.
4. The Trig. was unpiled/not unpiled, dimensions now being:

Description of mark: **Small cairn of stones** should be explicit, e.g. Steel plug, Brass plug, Bolt, G.I. Pipe

Height of mark.....m above below rock/concrete.....m above below G.L.

Height of Top Vanes to Top Mark.....m. Diameter of Vanes (vertical).....m.

Height of Cairn.....m. Diameter of Cairn.....m.

Length of Mast.....m. (approximate if not unpiled)

5. A.....set in conc/rock has been placed.....m. bearing.....°M from Trig. Mast
6. A.....set in conc/soil has been placed.....m. bearing.....°M from Trig. Mast
7. A.....set in conc/soil has been placed.....m. bearing.....°M from Trig. Mast
8. A.....set in conc/rock has been placed.....m. bearing.....°M from Trig. Mast
9. Connection.....to.....m. bearing.....°M
10. Connection.....to.....m. bearing.....°M
11. Connection.....to.....m. bearing.....°M
12. Connection.....to.....m. bearing.....°M
13. Diff. Ht.is.....m. above below
14. Diff. Ht.is.....m. above below
15. Diff. Ht.is.....m. above below
16. Diff. Ht.is.....m. above below

Prepared by: **K.H.O'Brien** Checked: **.....** Noted on U.T.M. Card

Date

Record of Station

Small cairn of stones only

~ 0.3m

