

7-0-06

CENTRAL MAPPING AUTHORITY
Department of Lands

Trigonometrical Survey of N.S.W.

RECONNAISSANCE and MAINTENANCE REPORT

STATION BERKLEY * T.S. 4962

Co: CAMDEN Ph: WOLLONGONG SOUTH No: 9029
Map Sheet: WOLLONGONG SOUTH
Inspected by: H. BORDER Date: 14th May, 1975.
Authority: C. M. A. Field Book: 1382

Note: Cross out word or words which do not apply

This Trig. Station has been:-

1. Completely cleared to permit 360° vision to surrounding Trigs.
2. Cleared by lanes bearing..... from Trig. Mast
3. Trig. Mast & Vanes have been painted white & black respectively. ✓
4. The Trig. was unpiled/~~not unpiled~~, dimensions ~~now being~~ Mast supported by Tripod

Description of mark: ~~Steel Pin in Concrete~~ should be explicit, e.g. Steel plug, Brass plug, Bolt, G.I. Pipe

Height of mark..... m above rock/concrete m above G.L.
below

Height of Top Vanes to Top Mark..... m. Diameter of Vanes (vertical)..... m.

Height of Cairn..... m. Diameter of Cairn..... m.

Length of Mast..... m. (approximate if not unpiled)

5. A Copper Nail set in conc/rock has been placed..... 2.18 m. bearing..... 218° M from Trig. Mast

6. A Copper Nail set in conc/soil has been placed..... 1.1 m. bearing..... 111° M from Trig. Mast

7. A..... set in conc/soil has been placed..... m. bearing..... °M from Trig. Mast

8. A..... set in conc/rock has been placed..... m. bearing..... °M from Trig. Mast

9. Connection Copper Nail to Copper Nail..... 11.508 m. bearing..... 77° M

10. Connection..... to..... m. bearing..... °M

11. Connection..... to..... m. bearing..... °M

12. Connection..... to..... m. bearing..... °M

13. Diff. Ht. Copper Nail in Conc Nails. 0.280 m. ~~above~~ Trig. Plug

14. Diff. Ht. Copper Nail in Conc Nails. 0.115 m. ~~above~~ Trig. Plug

15. Diff. Ht. is..... m. above

16. Diff. Ht. is..... m. above

Noted on U.T.M. Card

2/10/75

Prepared by: C. J. Brown Checked: [Signature] 2/10/75

Beacon Diagram

Net to Scale

Date	Record of Station


Checked

C. J. BROWN
SENIOR TRIGONOMETRICAL SURVEYOR

STATION BERKLEY O.P. 4962
 Current Occupant.....
 Address.....

Owners Name.....
 Address.....

Access 10-6-1975

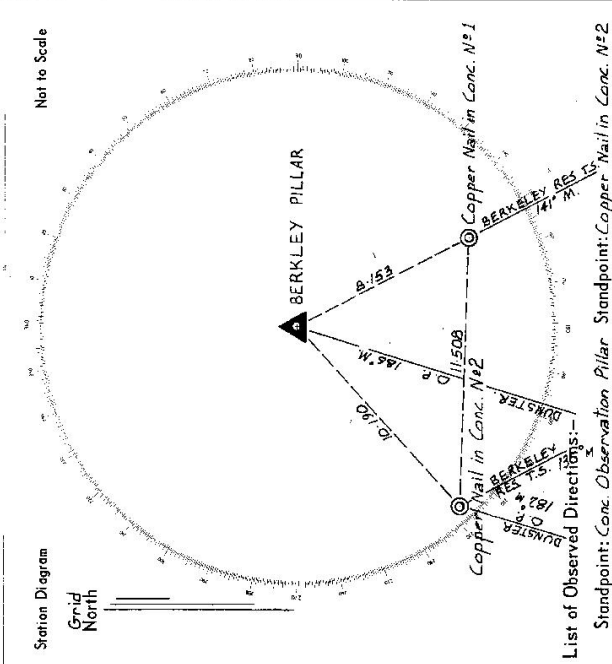

List of Observed Directions:-

Standpoint: Conc. Observation Pillar Standpoint: Copper Nail in Conc. N#2

Station	Direction	Station	Direction
BERKLEY RES. T.S.	359 59 60	BERKLEY RES. T.S.	359 59 60
Copper Nail in Conc. N#1	0 00 50	DUNSTER O.P.	76 52 59
DUNSTER O.P.	45 15 15	Pillar Spigot	252 28 40
Copper Nail in Conc. N#2	76 49 20	Copper Nail in Conc. N#1	302 05 40

Station	Direction	Station	Direction