



STATION BOMBOBIN 4975 (PILLAR)

Owners Name..... T.R. 38486  
 Current Occupant.....  
 Address.....  
 Address.....

21-5-1974


Access From Condabolin towards Parkes along Bogan Gate Parkes Road to Mile-Flag Bogan Gate, 30 Condabolin 10. 0-0 travel towards Parkes

Mileage

- 0-10 Take gravel track to your right at signpost, "Waioma", D.T. Jones Follow track across grid.
- 0-70 Pass house of Mr Jones on your Right, follow track past house. Take last gate on your right & follow track past house & sheds on your right.
- 0-95 Pass through double iron gates taking right fork in tracks, Follow track on R.H.S. of hay shed.
- 1-35 Take track to right over contour bank & follow track that winds around to northern end of Trig hill & thence to trig at 1.80 miles.

This station is of fairly easy access and in dry weather could be driven to by station sedan type vehicle. Caution should be used on last section of track due to rocky nature of this hill.

Station Diagram Not to Scale

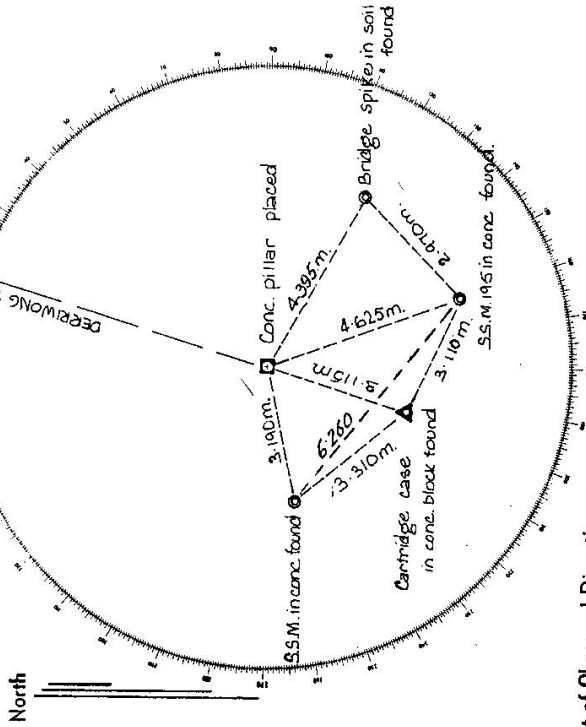

List of Observed Directions:-

Station	Direction	Station	Direction
DERRIMONG	T.S.	DERRIMONG	T.S.
TILGA	T.S.	TILGA	T.S.
S.S.M. in conc.	200° 33' 10	S.S.M. 19.5	138° 09' 30
Conc. pillar	0° 01' 20	Trig. Plug. P.	180° 01' 30
S.S.M. 19.5	45° 57' 30	S.S.M. in Conc. P.	243° 19' 00

Station	Direction	Station	Direction