

CENTRAL MAPPING AUTHORITY

GEODETIC SURVEY OF M.S.W.


GEODETIC STATION RECONNAISSANCE and MAINTENANCE REPORT

STATION: **CALWALLA** No: **4987**

MAP SHEET SCALE 1:250 000
INSPECTED BY: **Mollongson** DATE: **17-1-79**

AUTHORITY: **CMA** FIELD BOOK: **1723**

- Description:
- Note: *Cross out word or words which do not apply*
1. Cleared by lances bearing **151 / 154 - 164 / 172 - 343** from Trig. Mast
 2. Mast & Vanes have been painted white & black respectively. **NW54DB**
 3. The station/~~plate~~ was unpiled/~~not supplied~~/~~constructed~~ on 19 dimensions now being:
Description of mark. ~~S.P.M.~~ in conc. should be explicit, e.g., S/Steel Pillar Plate, Steel plug, Brass plug, Bolt, G.I. Pipe
Height of mark m. ^{above} rock/concrete; Mark is m. ^{above} G.L.
Height of Top Vanes to Top Mark/~~Pillar plate~~ **3.170** m. Diameter of Vanes (Vertical) **0.6** m. ^{square}
Height of Cairn m. Diameter of Cairn m. Name Plate found/not found/~~placed~~.
Length of Mast m. (approximate if not unpiled)
 4. A set in conc/rock has been placed/found, bearing ° M from Mast/Plug/Pillar
 5. A set in conc/rock has been placed/found, bearing ° M from Mast/Plug/Pillar
 6. A set in conc/rock has been placed/found, bearing ° M from Mast/Plug/Pillar
 7. A set in conc/rock has been placed/found, bearing ° M from Mast/Plug/Pillar
 8. Action required: **MOSS VALE**
 Sta. Topo.

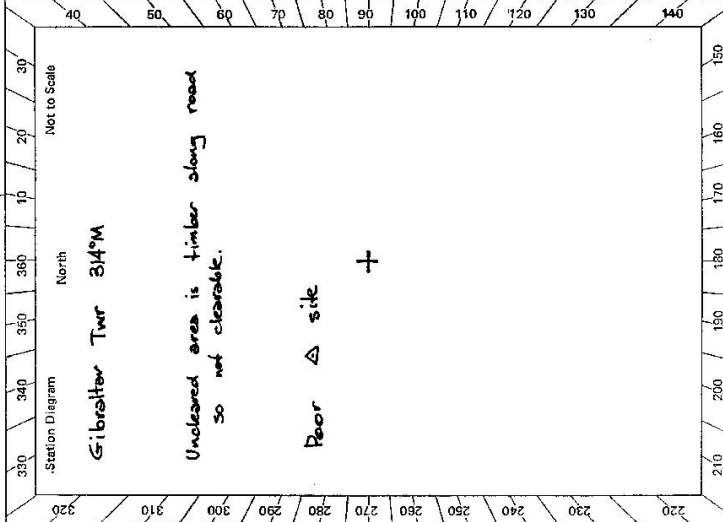


STANDPOINT:			
Mark	Direction	Horiz. Distance	Height Difference
			above standpt.
			below standpt.
			above standpt.
			below standpt.
Prepared by: *[Signature]* 25-1 Checked: *[Signature]* Noted on U.T.M. Card

St 2733-2 D. West, Government Printer

STATION CALWALLA IS 4987

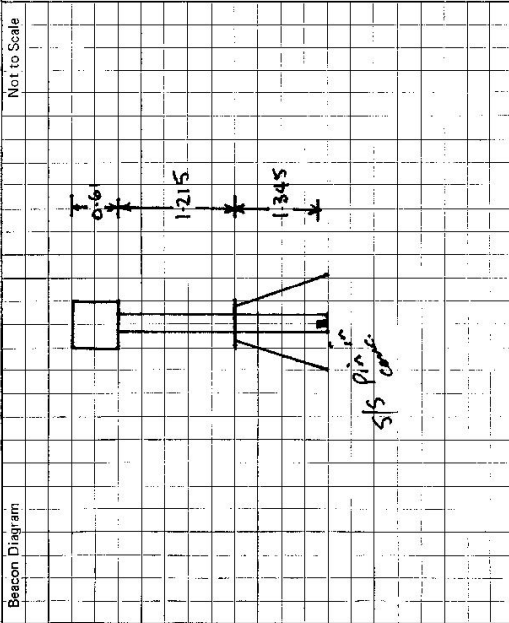

Owner's Name:
 Address:
 Phone:
 Current Occupant:
 Address:
 Phone:

ACCESS

Access Report of 17/1/19 was found suitable/unsuitable,
 ZAND

- km 0.0 Bound P.O. towards Moss Vale
- 0.8 Take R fork towards Robertson
- 5.4 Bong Bong racecourse on R
- 8.8 Boss road on L
- 9.7 Turn L towards KANGALON 7
- 10.5 Through gate on R to Δ

This section to be completed by officer constructing pillar.

Original station mark found/not found.

Description of mark:

Original beacon found/not found.

Description of beacon:

Height Top of Vanes to Top Mark:m.

Height of mark:m. above rock/concm. above G.L.
 below rock/concm. below G.L.

Diameter of Vanesm.

Height of Cairnm.

Original Beacon has/has not been destroyed by me.

Date

Record of Station