

CENTRAL MAPPING AUTHORITY

GEODETIC SURVEY OF NSW

GEODETIC STATION RECONNAISSANCE and MAINTENANCE REPORT

Description:

1. Cleared by lances bearing..... *orange* from Trig. Mast
Note: Cross out word or words which do not apply
2. Mast & Vanes have been painted white & ~~black~~ *orange* respectively.
3. The station/~~pillar~~ *was unpiled/ret-empiled/constructed on* 19....., dimensions now being:
Description of mark ~~24 in. rock~~ *24 in. rock* should be explicit. e.g., S/Steel Pillar Plate, Steel plug, Brass plug, Bolt, G.I. Pipe
~~below tripod~~ *above*m. ~~above~~ *below* rock/concrete;
Height of mark.....m. ~~above~~ *below* G.L.
Height of Top Vanes to Top Mark/Pillar platem. Diameter of Vanes (vertical).....m.
Height of Cairn.....m. Diameter of Cairn.....m. Name Platefound/not found/obscured.
Length of Mast.....m. (approximate if not unpiled)
4. A.....set in conc/rock has been placed/found, bearing.....° M from Mast/Plug/Pillar
5. A.....set in conc/rock has been placed/found, bearing.....° M from Mast/Plug/Pillar
6. A.....set in conc/rock has been placed/found, bearing.....° M from Mast/Plug/Pillar
7. A.....set in conc/rock has been placed/found, bearing.....° M from Mast/Plug/Pillar
8. Action required:.....

BARRIER
Stn. Top

STANDPOINT:			
Mark	Direction	Horiz. Distance	Height Difference
			above standpt.
			below
			above standpt.
			below
Prepared by: *A. Siversten* 22.1
Checked: *[Signature]*

Noted on U.T.M. Card

St 2733--1

STATION: **CUMBURMURRA** No.: **5022**

MAP SHEET SCALE 1:250 000 **Wollongong**

INSPECTED BY: **A. Siversten** DATE: **18-1-79**

AUTHORITY: **CMA** FIELD BOOK: **1724**

North

Station Diagram

Not to Scale

35 - 245°M Suckering required
Extensive views in this direction
MOOLATOO Δ 142°M
ETTERLEMA Hill 178°M


245-35 Not usable because
Δ is below top of
hill on cliff edge

+
Pillar Δ site

Checked

8: 2735-2 D. West, Government Printer

STATION **CUMBERMURRA TS 5002**

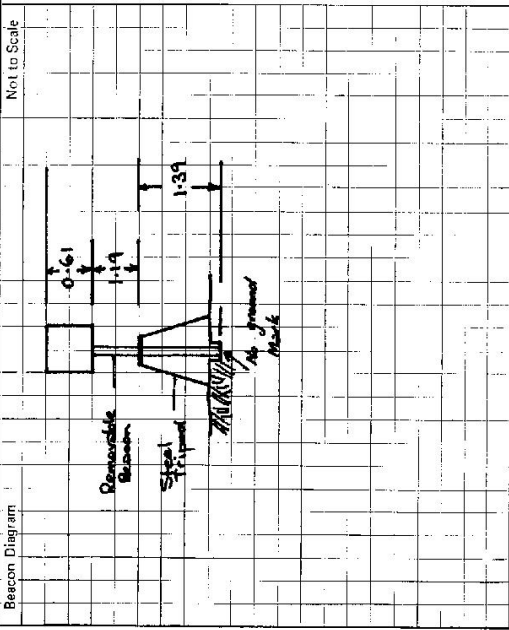

Owner's Name: **M. MORTON NATIONAL PARK**
 Address:
 Phone:
 Current Occupant:
 Address:
 Phone:

Access Report of **18.1.1977** was found suitable/unsuitable.
4WD
 ACCESS
 DATE: **JAN 79**

0.0 km Take road from TALLONG towards CAIOORA H d BADGERYS L-O
3.2 Pass BADGERYS LO road on R
20.2 Take CAIOORA RIDGE Fire Trail to L (Just after 'Swingslope' property)
29.75 Take faint wheel tracks to R
30.3 → these are 150 m before a fork in the main track CUMBERMURRA Δ

This section to be completed by officer constructing pillar.
 Original station mark found/not found.
 Description of mark:
 Original beacon found/not found.
 Description of beacon:
 Height: Top of Vanes to Top Mark.....m.
 Height of mark.....m above G.L. below G.L.
 Diameter of Vanes.....m. Height of Cairn.....m.
 Original Beacon has/has not been destroyed by me.

Date	Report of Station