

CENTRAL MAPPING AUTHORITY

GEODETIC SURVEY OF N.S.W.

GEODETIC STATION RECONNAISSANCE and MAINTENANCE REPORT

Description:

1. Cleared by lanes bearing.....  
*Note: Cross out word or words which do not apply*
2. Mast & Vanes have been painted white & black respectively.
3. The station/pillar was supplied/not supplied/constructed on.....19..... dimensions now being:  
Description of mark.....should be explicit, e.g., S/Steel Pillar Plate, Steel plug, Brass plug, Bolt, G.I. Pipe  
Height of mark.....<sup>above</sup>.....<sup>below</sup>.....m. Mark is.....<sup>above</sup>.....<sup>below</sup>.....m. G.L.  
Diameter of Vanes (vertical).....m.
- Height of Top Vanes to Top Mark/Pillar plate.....m. Name Plate found/not found/placed.
- Height of Cairn.....m. Diameter of Cairn.....m.
- Length of Mast.....m. (approximate if not unipied)
4. A.....set in conc/rock has been placed/found, bearing.....° M from Mast/Plug/Pillar
5. A.....set in conc/rock has been placed/found, bearing.....° M from Mast/Plug/Pillar
6. A.....set in conc/rock has been placed/found, bearing.....° M from Mast/Plug/Pillar
7. A.....set in conc/rock has been placed/found, bearing.....° M from Mast/Plug/Pillar
8. Action required:.....

STANDPOINT:

Mark	Direction	Horiz. Distance	Height Difference	Mark	Direction	Horiz. Distance	Height Difference
			above standpt.				above standpt.
			below standpt.				below standpt.
			above standpt.				above standpt.
			below standpt.				below standpt.
Prepared by: J. Sutton 29/8/75 Checked: C. M.A. 3/9/81

Sr 2733-1

Noted on U.T.M. Card


Checked

STATION: DONALDSON (OLD) No.: 5007

MAP SHEET SCALE 1:250 000 WARWICK

INSPECTED BY: J. SUTTON DATE: 29th Aug, '75

AUTHORITY: C.M.A. FIELD BOOK: —

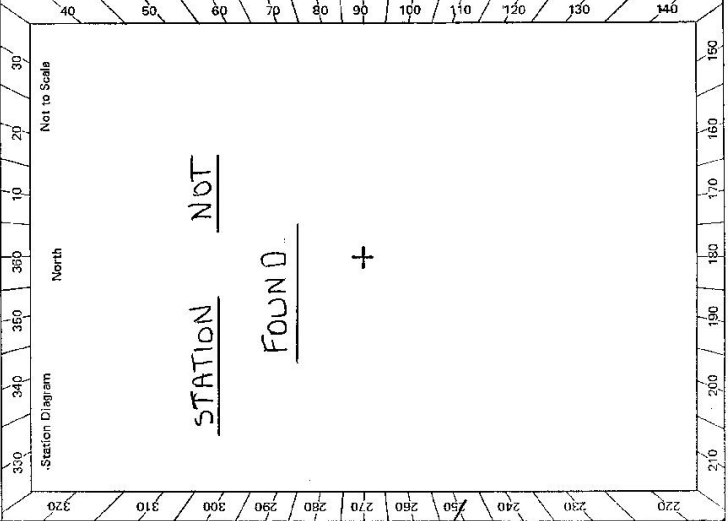

St 2733-2 D. West, Government Printer

Beacon Diagram	Not to Scale
<p><u>STATION NOT FOUND</u></p>	

STATION DONALDSON (OLD) IS 5007

Owner's Name: National Parks (Qld)

Current Occupant: N.P.A.N.S (Qld)

Address: .....

Phone: .....

ACCESS 29. 8-1979

Access Report of 1/18/44 was found ~~unsuitable~~.  
 From Tentworth P.D. proceed towards Stanthorpe.  
 Turn left onto Bruener Highway for 25-40 km.  
 At fingerboard "Back Creek Road" turn right.  
 By pass access road into "Sailor Jack" and continue along road.  
 By pass access road into "Aralson" and continue along road.  
 At grid signposted "Back Creek" go straight ahead ignoring track to left to "Glenayre".  
 At fingerboard "Back Creek" go left along track.  
 At signpost "Private- No Entry" turn left along grassy track.  
 Cross gully 47.85 Cross gully.  
 Cross gully 48.35 Go through gate in fence line.  
 Cross gully 48.40 Follow faint track through grass and up spur to ridge top.  
 Cross small gully 50.60 above dam.  
 At tall hut and border fence swing right along fence.  
51.10 Through single wooden gate in fence line.  
51.15 Stop vehicle at fence intersection. Cross over fence and follow fence line along ridge tops until it cuts west into valley. Cross over fence and continue along ridge through thick scrub and turn west into saddle and onto high point then head WNW to Trig.  
 Trig is 2 hours walk (scrub-bashing).

Km: 0.00  
 5.25  
 30.65  
 40.10  
 41.80  
 44.80  
 45.50  
 47.75  
 47.80  
 48.35  
 48.40  
 50.60  
 51.10  
 51.15  
 52.35

This section to be completed by officer constructing pillar.

Original station mark found/not found.

Description of mark: .....

Original beacon found/not found.

Description of beacon: ..... m.

Height Top of Vanes to Top Mark ..... m.

Height of mark ..... m. above or below

Diameter of Vanes ..... m. Height of Cairn ..... m.

Original Beacon has/has not been destroyed by me.

Date .....

Record of Station .....