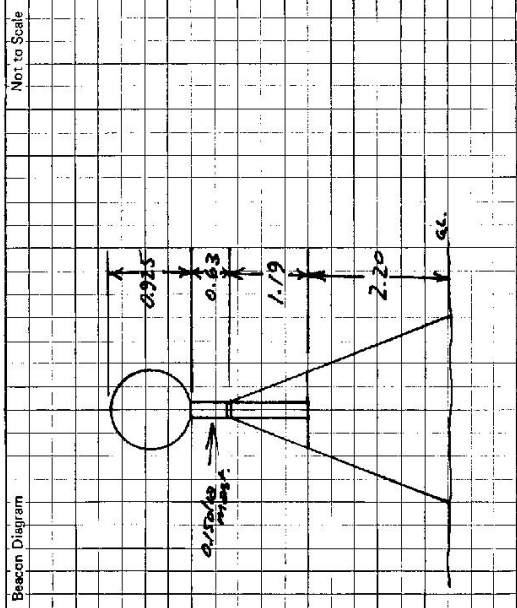


STATION Kinnoull G.S. TS 5042	Owner's Name: Address: Phone:	Current Occupant: Address: Phone:	
Access Report or 18.1.17 was found suitable/unsuitable.		ACCESS Direction Bearnaid Rd. Head south towards Moss Lake Turn left sign Robertson. Kingsdown Rd Pass Hawkins Rd on left. Turn left into Tourist Rd. Turn right through grid to house. Pass house on your right Go through gate on RHS of shed/sg across base through another gate and head down hill. Go through gate across earth bridge then make way to top of hill. Trig just over fence line	
Km 0.00 0.80 5.40 8.85 9.90 10.20 10.30 10.80			
Not to Scale 			
This section to be completed by officer constructing pillar.			
Original station mark found/not found.			
Description of mark:			
Original beacon found/not found.			
Description of beacon:			
Height Top of Vanes to Top Markm.			
Height of markm. above rock/concm. below G.L.			
Diameter of Vanesm. Height of Cairnm.			
Original Beacon has/has not been destroyed by me.			
			Date Record of Station