

CENTRAL MAPPING AUTHORITY
Department of Lands

Trigonometrical Survey of N.S.W.

RECONNAISSANCE and MAINTENANCE REPORT

This Trig. Station has been:

Note: Cross out word or words which do not apply


1. Completely cleared to permit 360° vision to surrounding Trigs. ✓
2. Cleared by lanes bearing from Trig. Mast
3. Trig. Mast & Vanes have been painted white & black respectively.
4. The Trig. was emptied/not unpiled, dimensions now being:
 - Description of mark should be explicit, e.g. Steel plug, Brass plug, Bolt, G.I. Pipe
 - Height of mark m above rock/concrete m above G.L.
 - Height of Top Vanes to Top Mark m. Diameter of Vanes (vertical) 0.65 m.
 - Height of Cairn 1.00 m. Diameter of Cairn 2.00 m.
 - Length of Mast 3.705 m. (approximate if not unpiled)

5. A set in conc/rock has been placed m. bearing °M from Trig. Mast
6. A set in conc/soil has been placed m. bearing °M from Trig. Mast
7. A set in conc/soil has been placed m. bearing °M from Trig. Mast
8. A set in conc/rock has been placed m. bearing °M from Trig. Mast
9. Connection to m. bearing °M
10. Connection to m. bearing °M
11. Connection to m. bearing °M
12. Connection to m. bearing °M
13. Diff. Ht. is m. above
14. Diff. Ht. is m. below
15. Diff. Ht. is m. above
16. Diff. Ht. is m. below

Prepared by: M.L. Morrison Checked: Noted on U.T.M. Card

STATION HAT HEAD OLD TS 5050
 Co: MACQUARIE Pt: KINCHELA
 Map Sheet: KARASORO POINT No: 9535
 Inspected by: M.L. Morrison Date: 5-8-77
 Authority: Field Book: 1581

Beacon Diagram

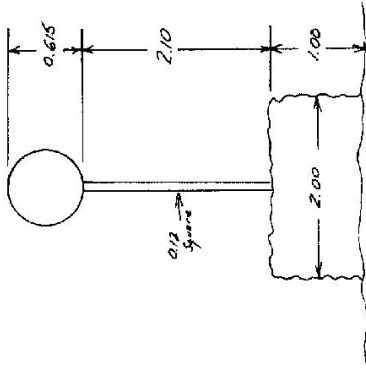

Date

Record of Station
 TRIG. PD IN FAIR CONDITION NEEDS NEW VANES AND MAST (WAS ABOUT WITH PERMANENT) 5.11M IN ROCK. Ht. Abt 2hrs CLEARING OF LOW SANDRA REQUIRED.

Checked

